



NOTES TYPICAL FOR DRAWINGS
 C-1, C-2 & C-3:
 1. CASEWORK TO BE FURNISHED & INSTALLED THIS CONTRACT
 2. OTHERS ARE TO PROVIDE WOOD OR METAL BLOCKING FOR SUPPORT OF OVERHEAD CABINETS. LOCATION PER CASEWORK SHOP DWGS.
 3. SEE DWG. C-3 FOR ADDITIONAL NOTES.

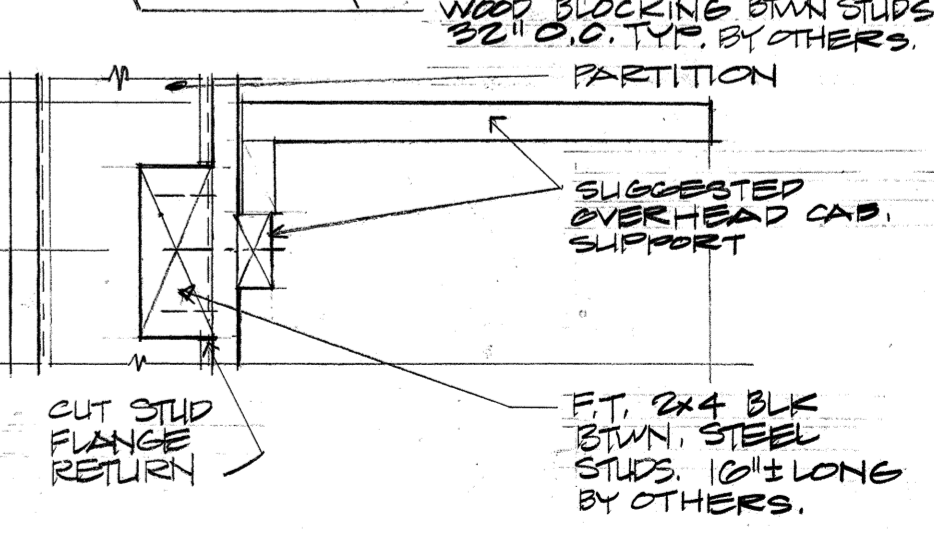

A OVERHEAD CABINET BLOCKING

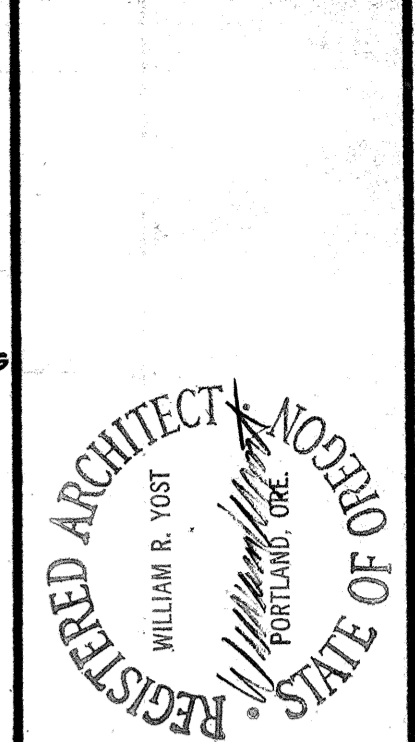

Campbell Yost Grube
 Professional Corporation
 Architecture & Planning
 2040 Southwest Jefferson • Portland Oregon 97201 • 503-221-0150

CASEWORK PLANS & ELEVATIONS
 PROFESSIONAL SCHOOLS BUILDING
 PHASE I
 PORTLAND STATE UNIVERSITY
 PORTLAND, OREGON

date 10 JAN. 1980
 revision
 14 MAY 1981 AS-BUILT
 project number 249
 drawn by

