
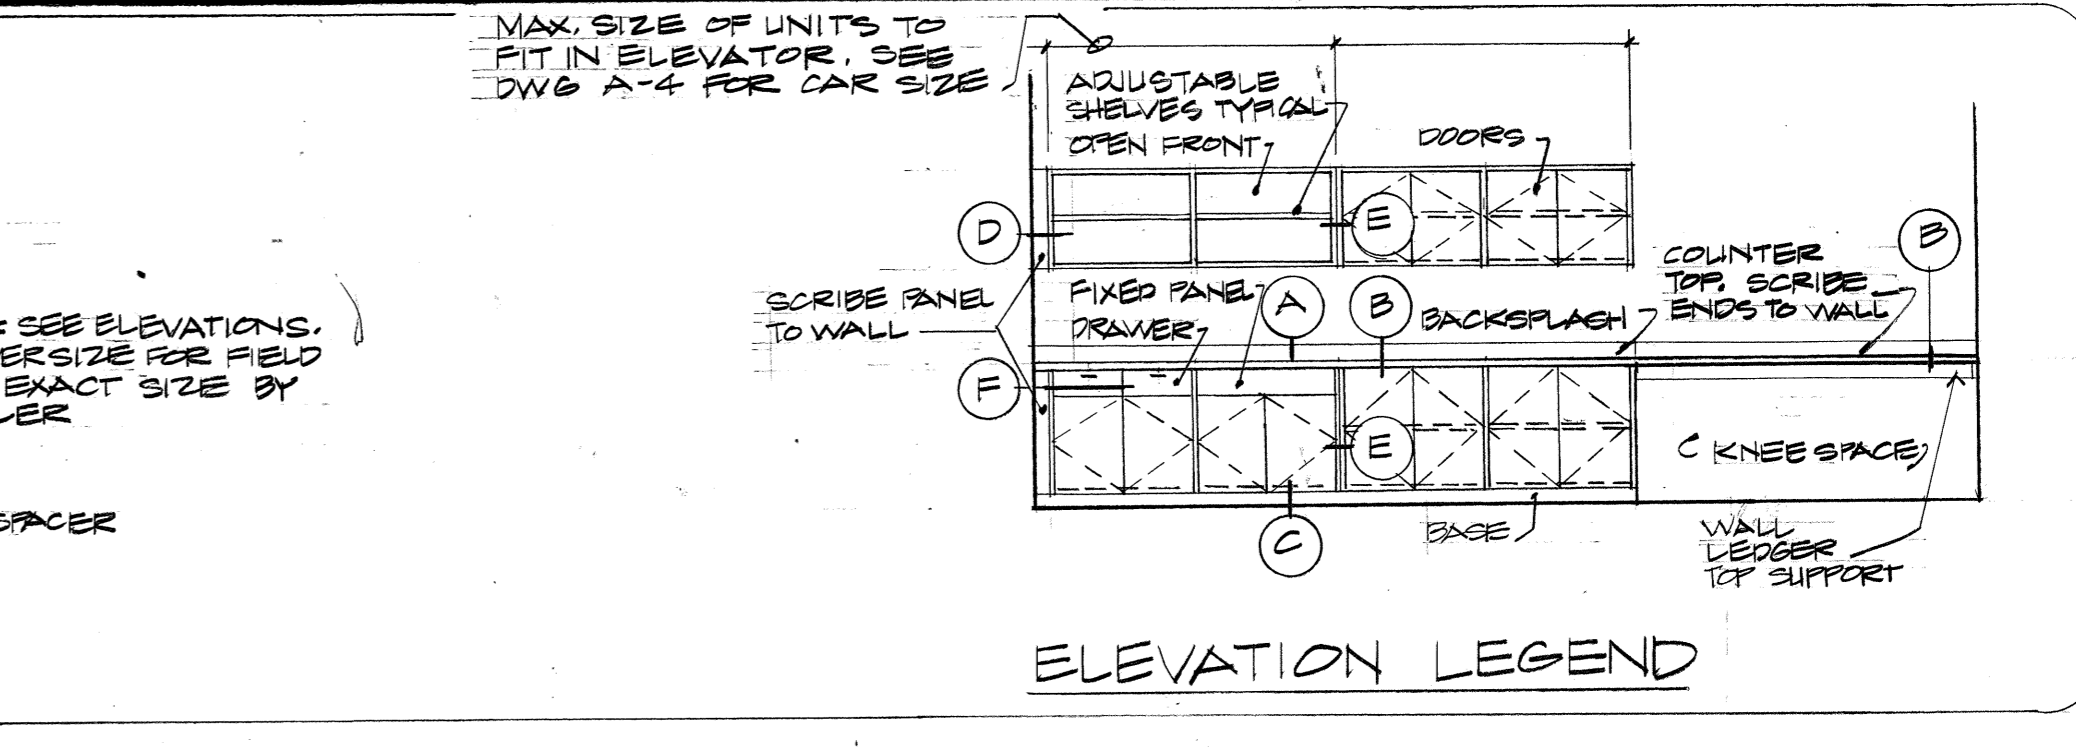


NOTE:
 A. EQUIPMENT TO BE FURNISHED & INSTALLED BY OTHERS. PROVIDE CUT-OUTS & REQUIRED OPENINGS UNDER THIS CONTRACT.
 1. "ELTER" SINKS:
 S-1: SL-2125-A-GR I.D. 16"x22"x 7/8" DEEP
 S-2: DL-2130-A-GR I.D. EA. ROOM 16"x14"x 7/8" D.
 S-3: SL-1515-A-GR I.D. 9"x12"x 6" DEEP
 2. UNDERCOUNTER REFRIGERATOR:
 "FRIGIDAIRE" I-43
 3. UPRIGHT REFRIGERATOR:
 "GENERAL ELECTRIC" TA-14 SW
 4. COOKTOP:
 "THERMADOR" TMH 34
 5. EXHAUST FAN:
 "NUTONE" V-54 SS 30
 6. DISHWASHER:
 "KITCHEN AID" CUSTOM MODEL
 B. OMIT BACKS ON CABINETS WITH SINKS
 C. INSTALL BASE CABINETS OVER FINISH FLOORING (CARPET OR RESILIENT)

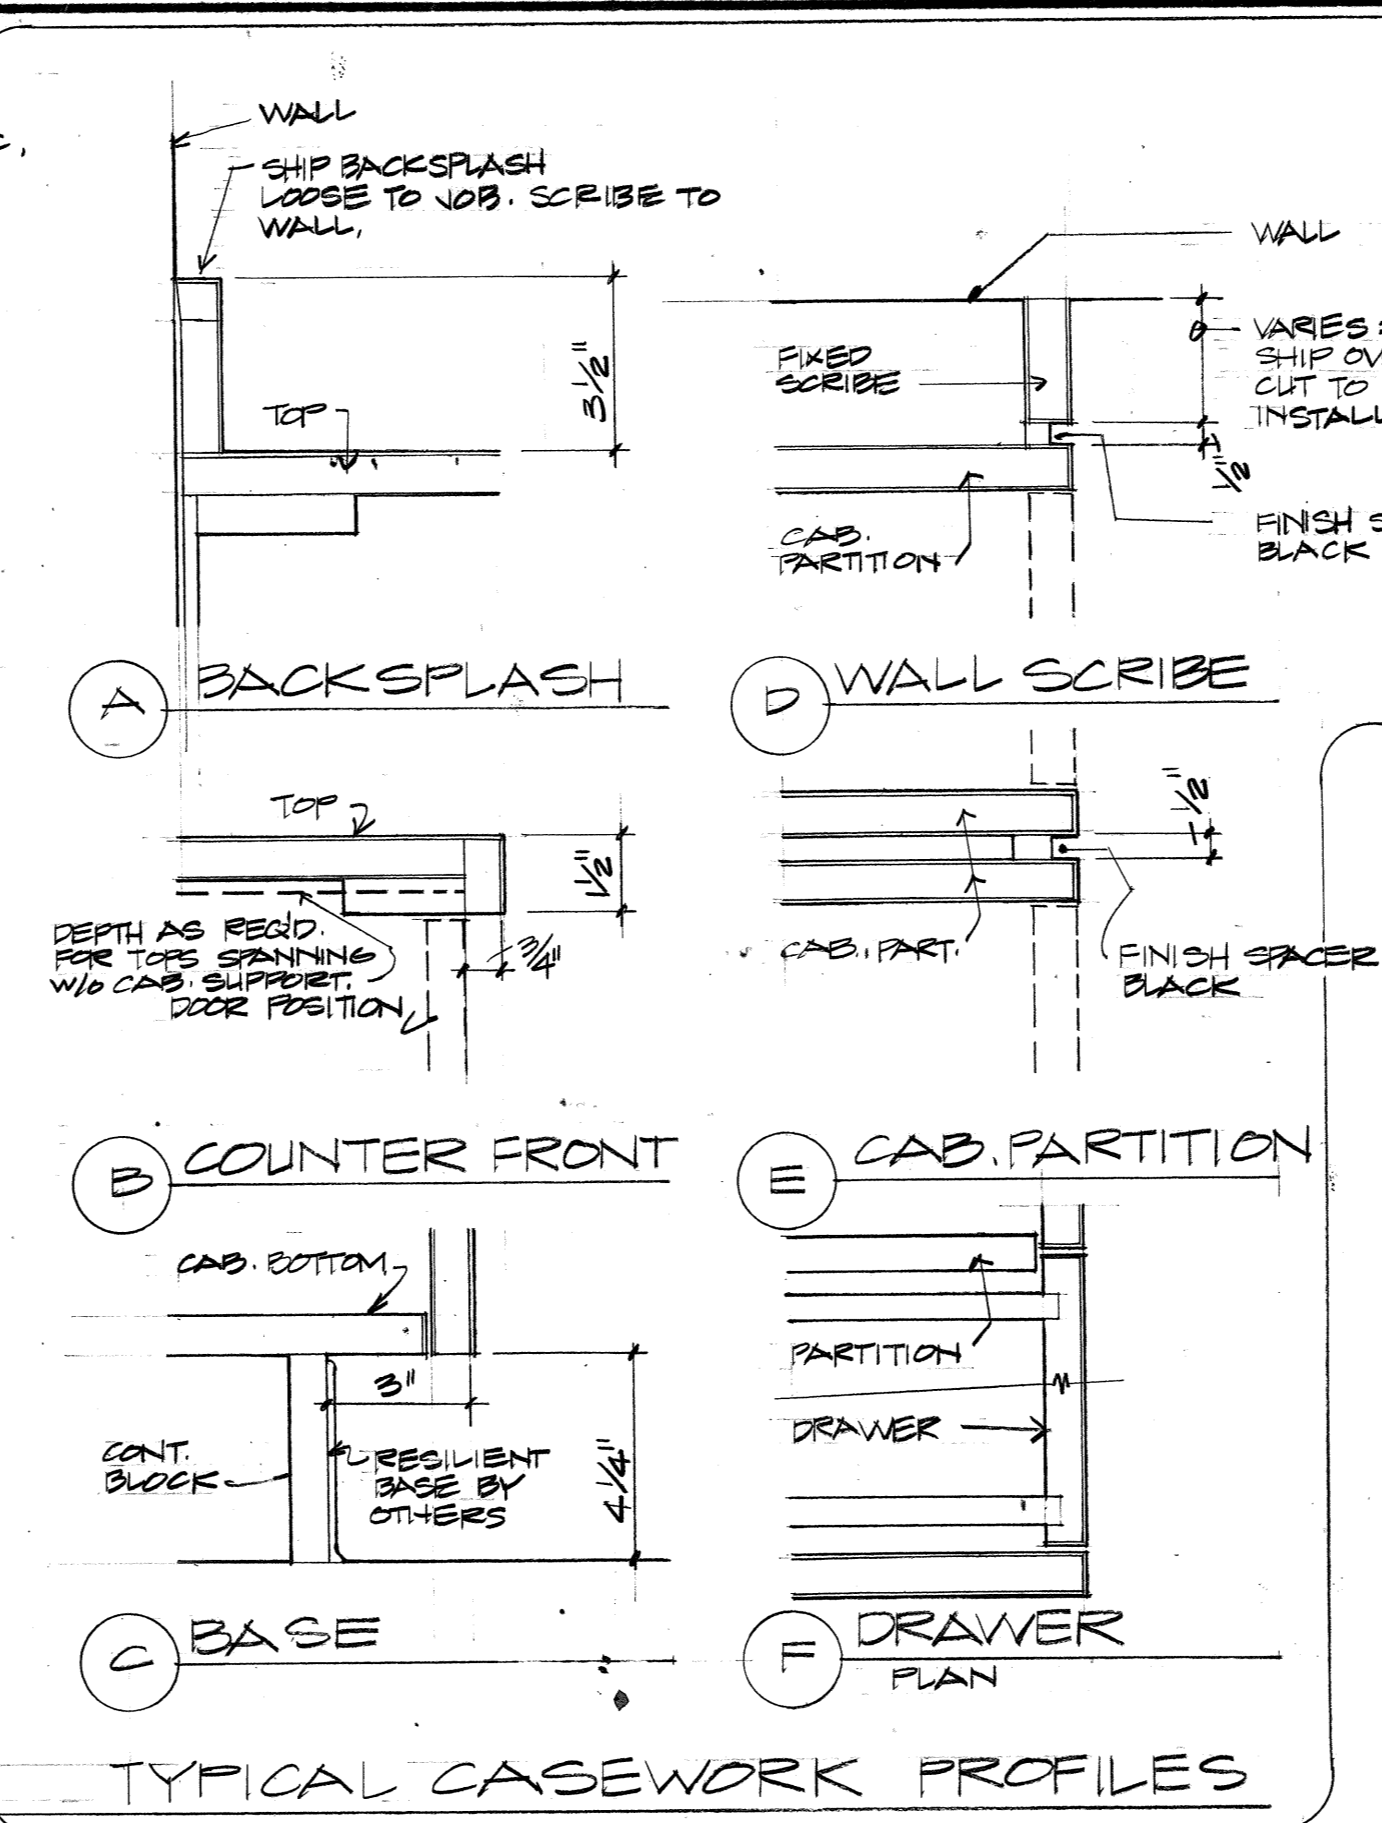

CASEWORK PLANS, ELEVATIONS & DETAILS

PROFESSIONAL SCHOOLS BUILDING (EDUCATION) PHASE I

PORTLAND STATE UNIVERSITY PORTLAND, OREGON

Campbell Yost Grube
 Professional Corporation
 Architecture & Planning
 2040 Southwest Jefferson • Portland Oregon 97201 • 503-221-0150

date 10 JAN. 1980 scale 1/4" = 1'-0"
 revision
 14 MAY 1981 AS-BUILT
 project number 249
 drawn by

3