

STAGE II
223-2607
344-3249

WILMSEN ENDICOTT UNTHANK & ASSOCIATES AIA


812 S. W. WASHINGTON
863 THIRTEENTH AVENUE EAST
EUGENE, OREGON 97401

ARCHITECTS


APPROVED
DRAWN
DATE
JOB

AS BUILT
REVISIONS
DATE
JOB


MIG

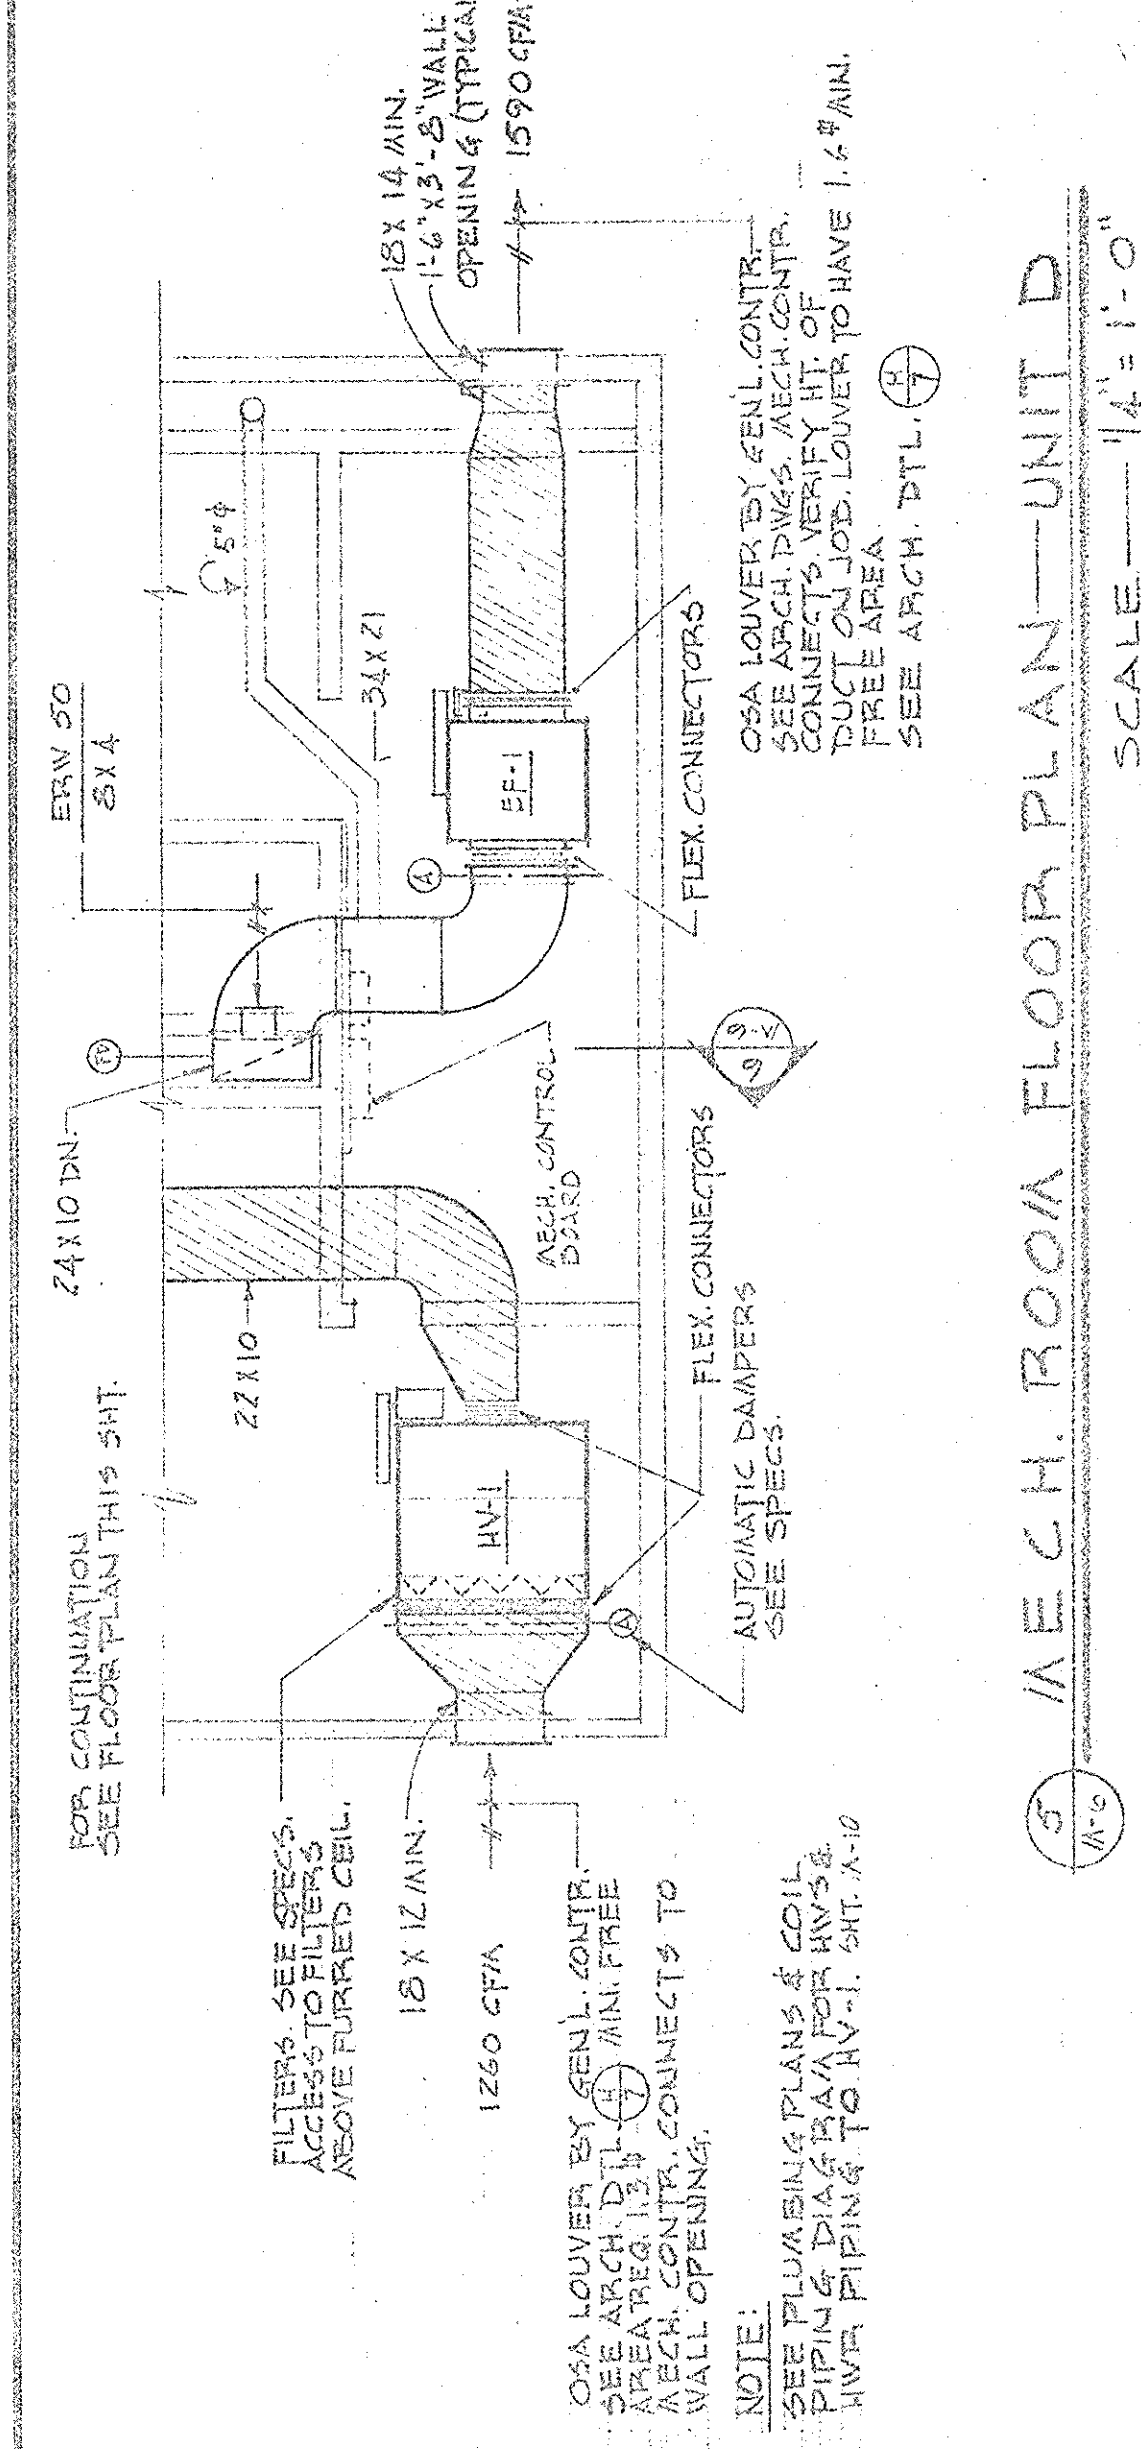


MECH. ROOM FLOOR PLAN—UNIT D
SCALE: 1/4" = 1'-0"

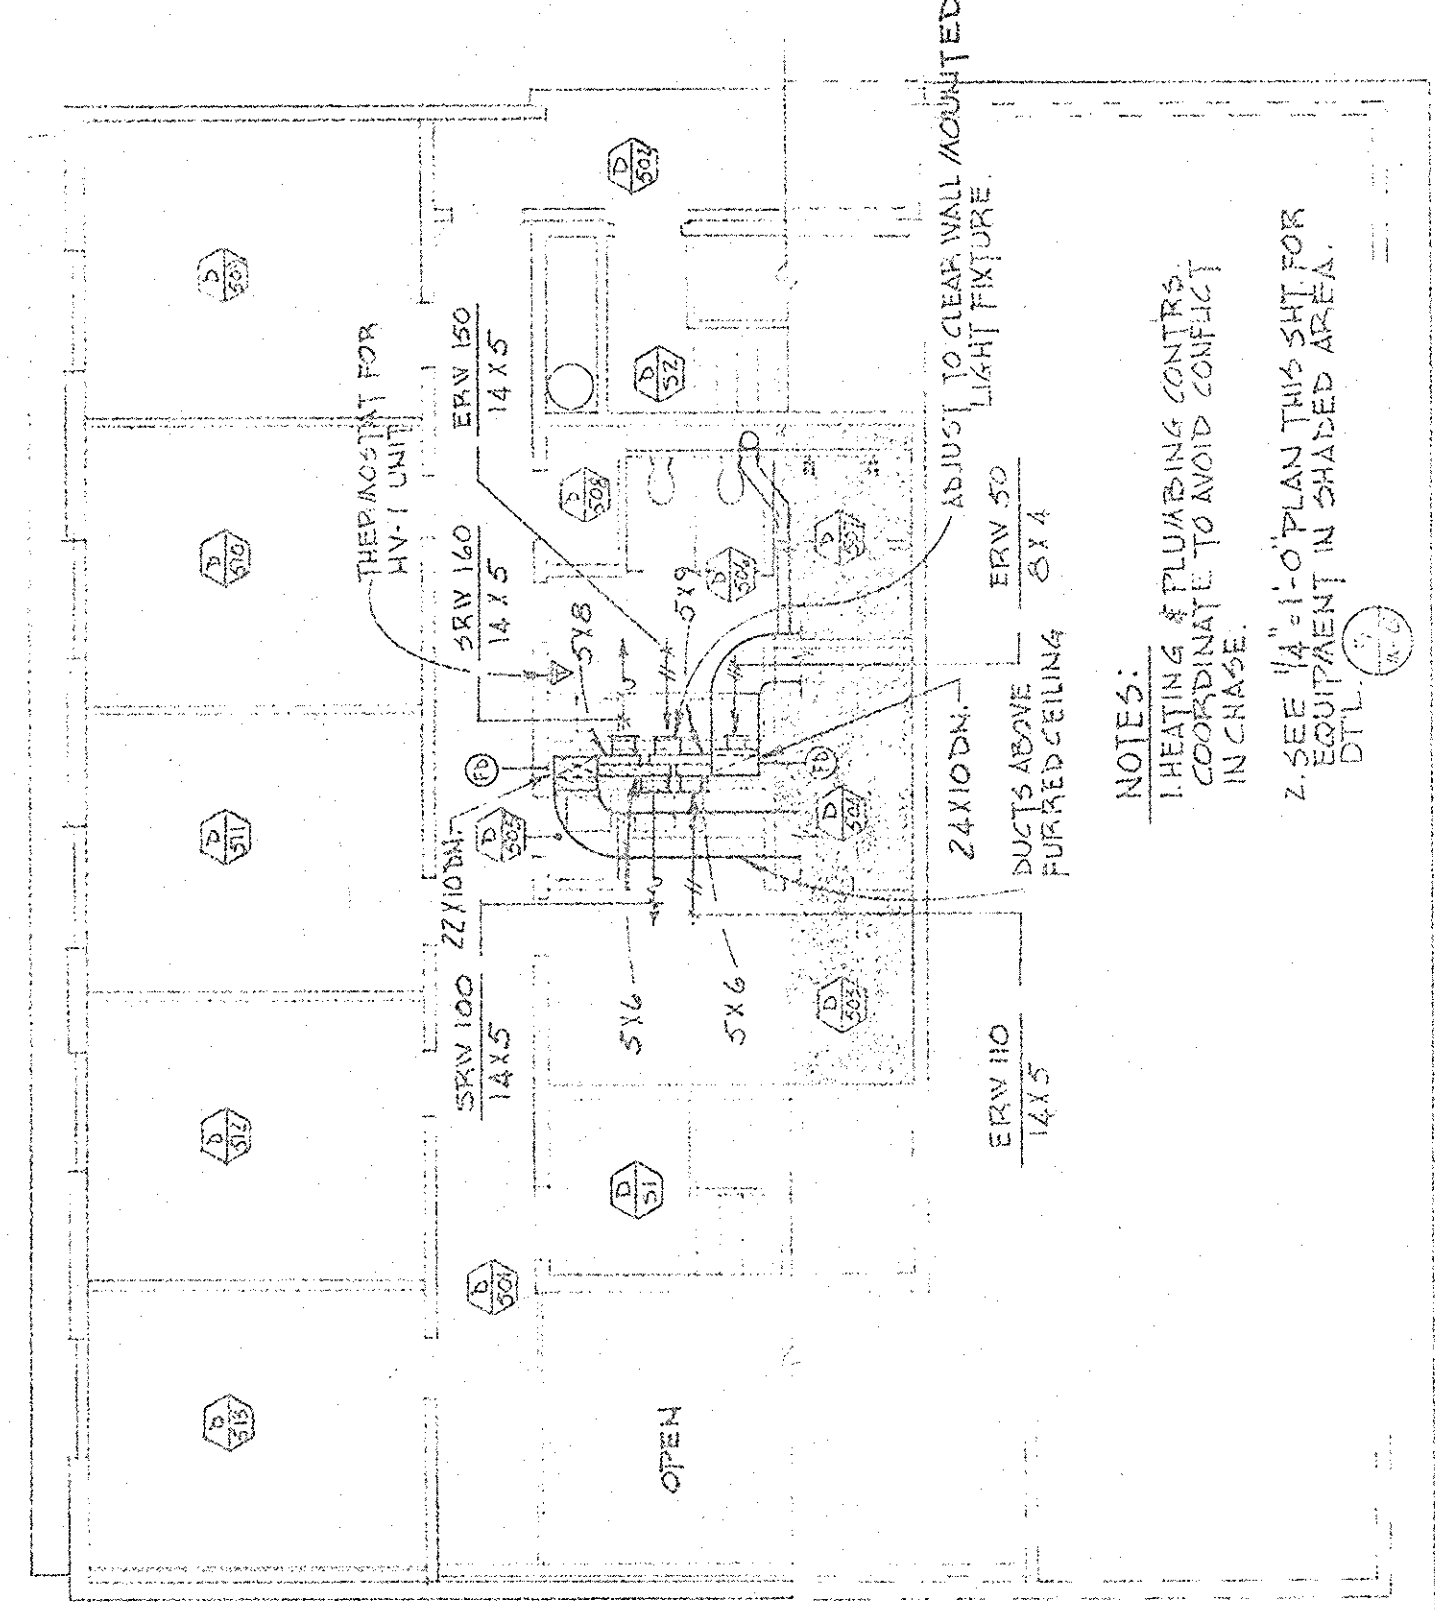


FIFTH FLOOR PLAN—UNIT D
SCALE: 1/8" = 1'-0"

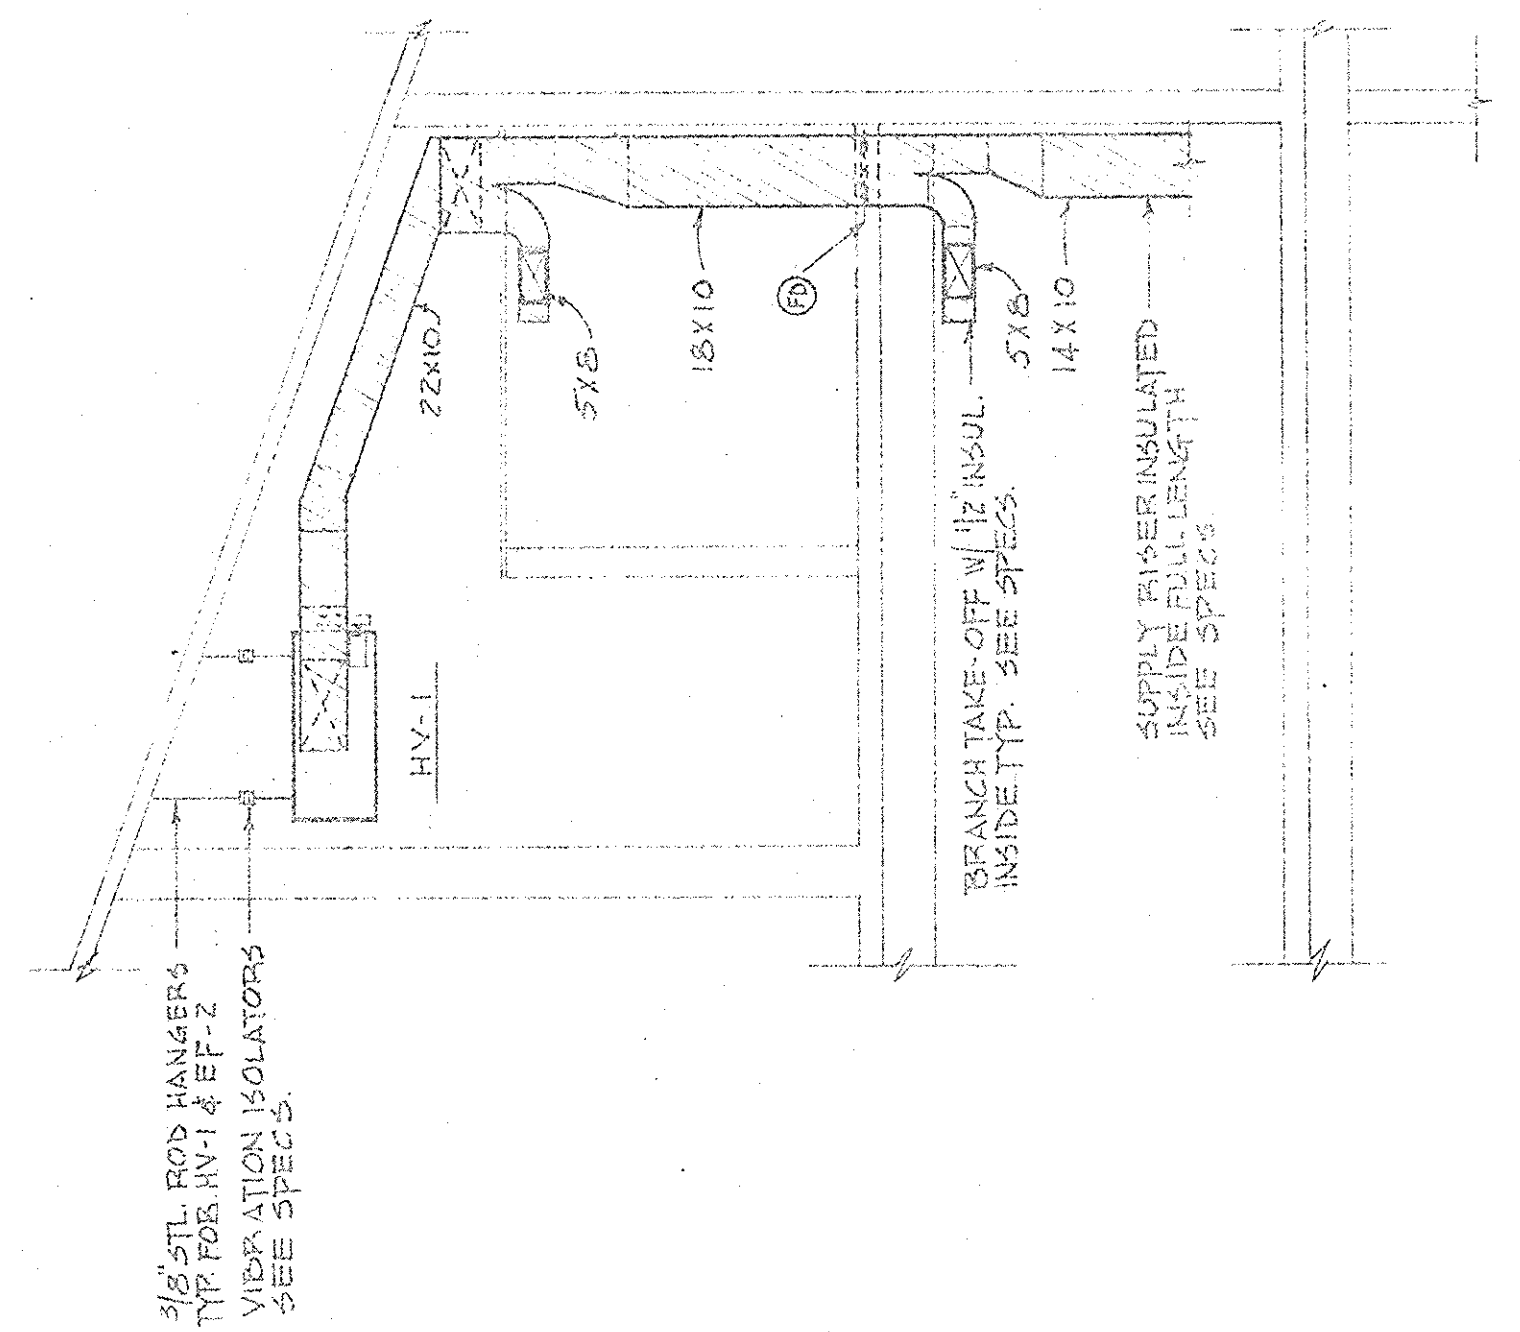


SECTION MECH. RA—UNIT D
SCALE: 1/4" = 1'-0"

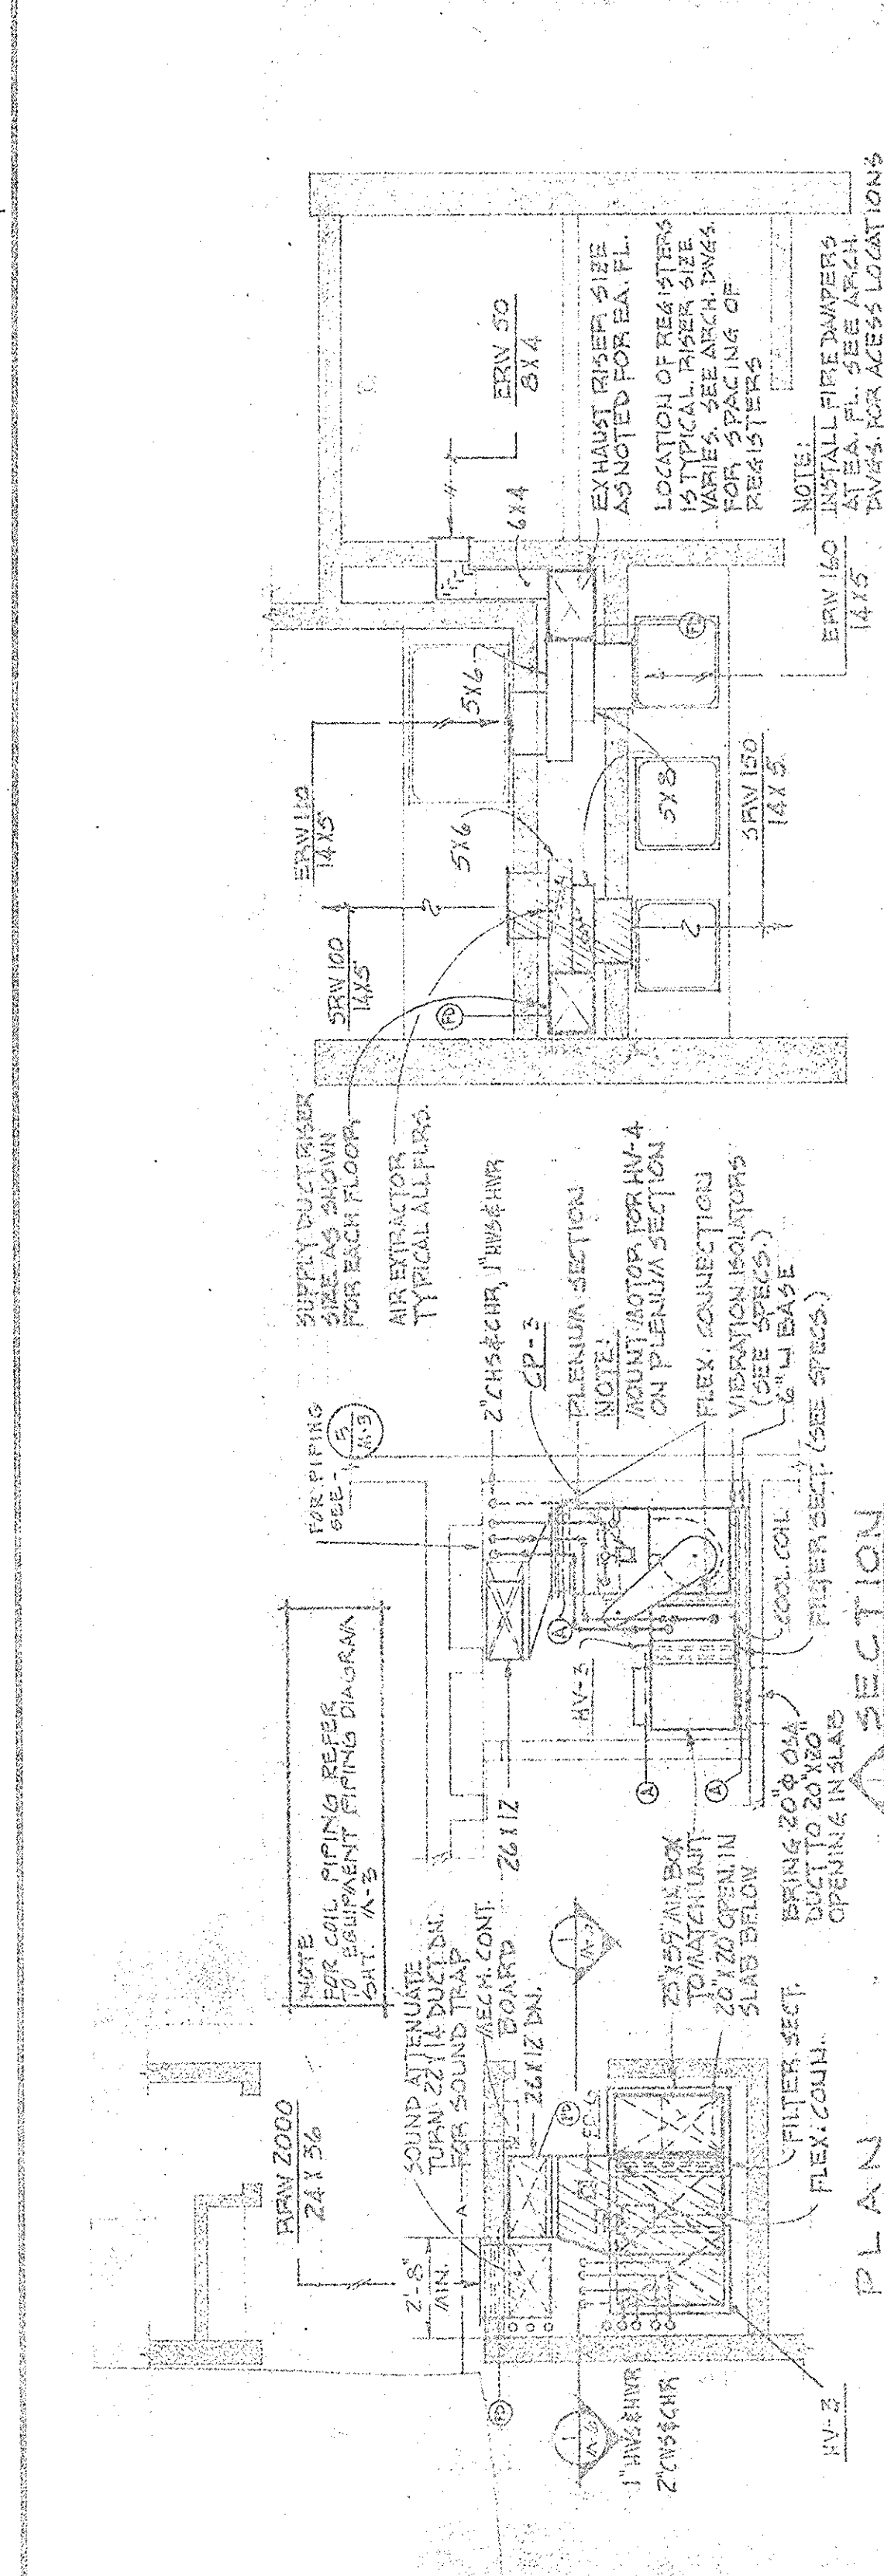


MECHANICAL ROOM—UNIT D
SCALE: 1/4" = 1'-0"

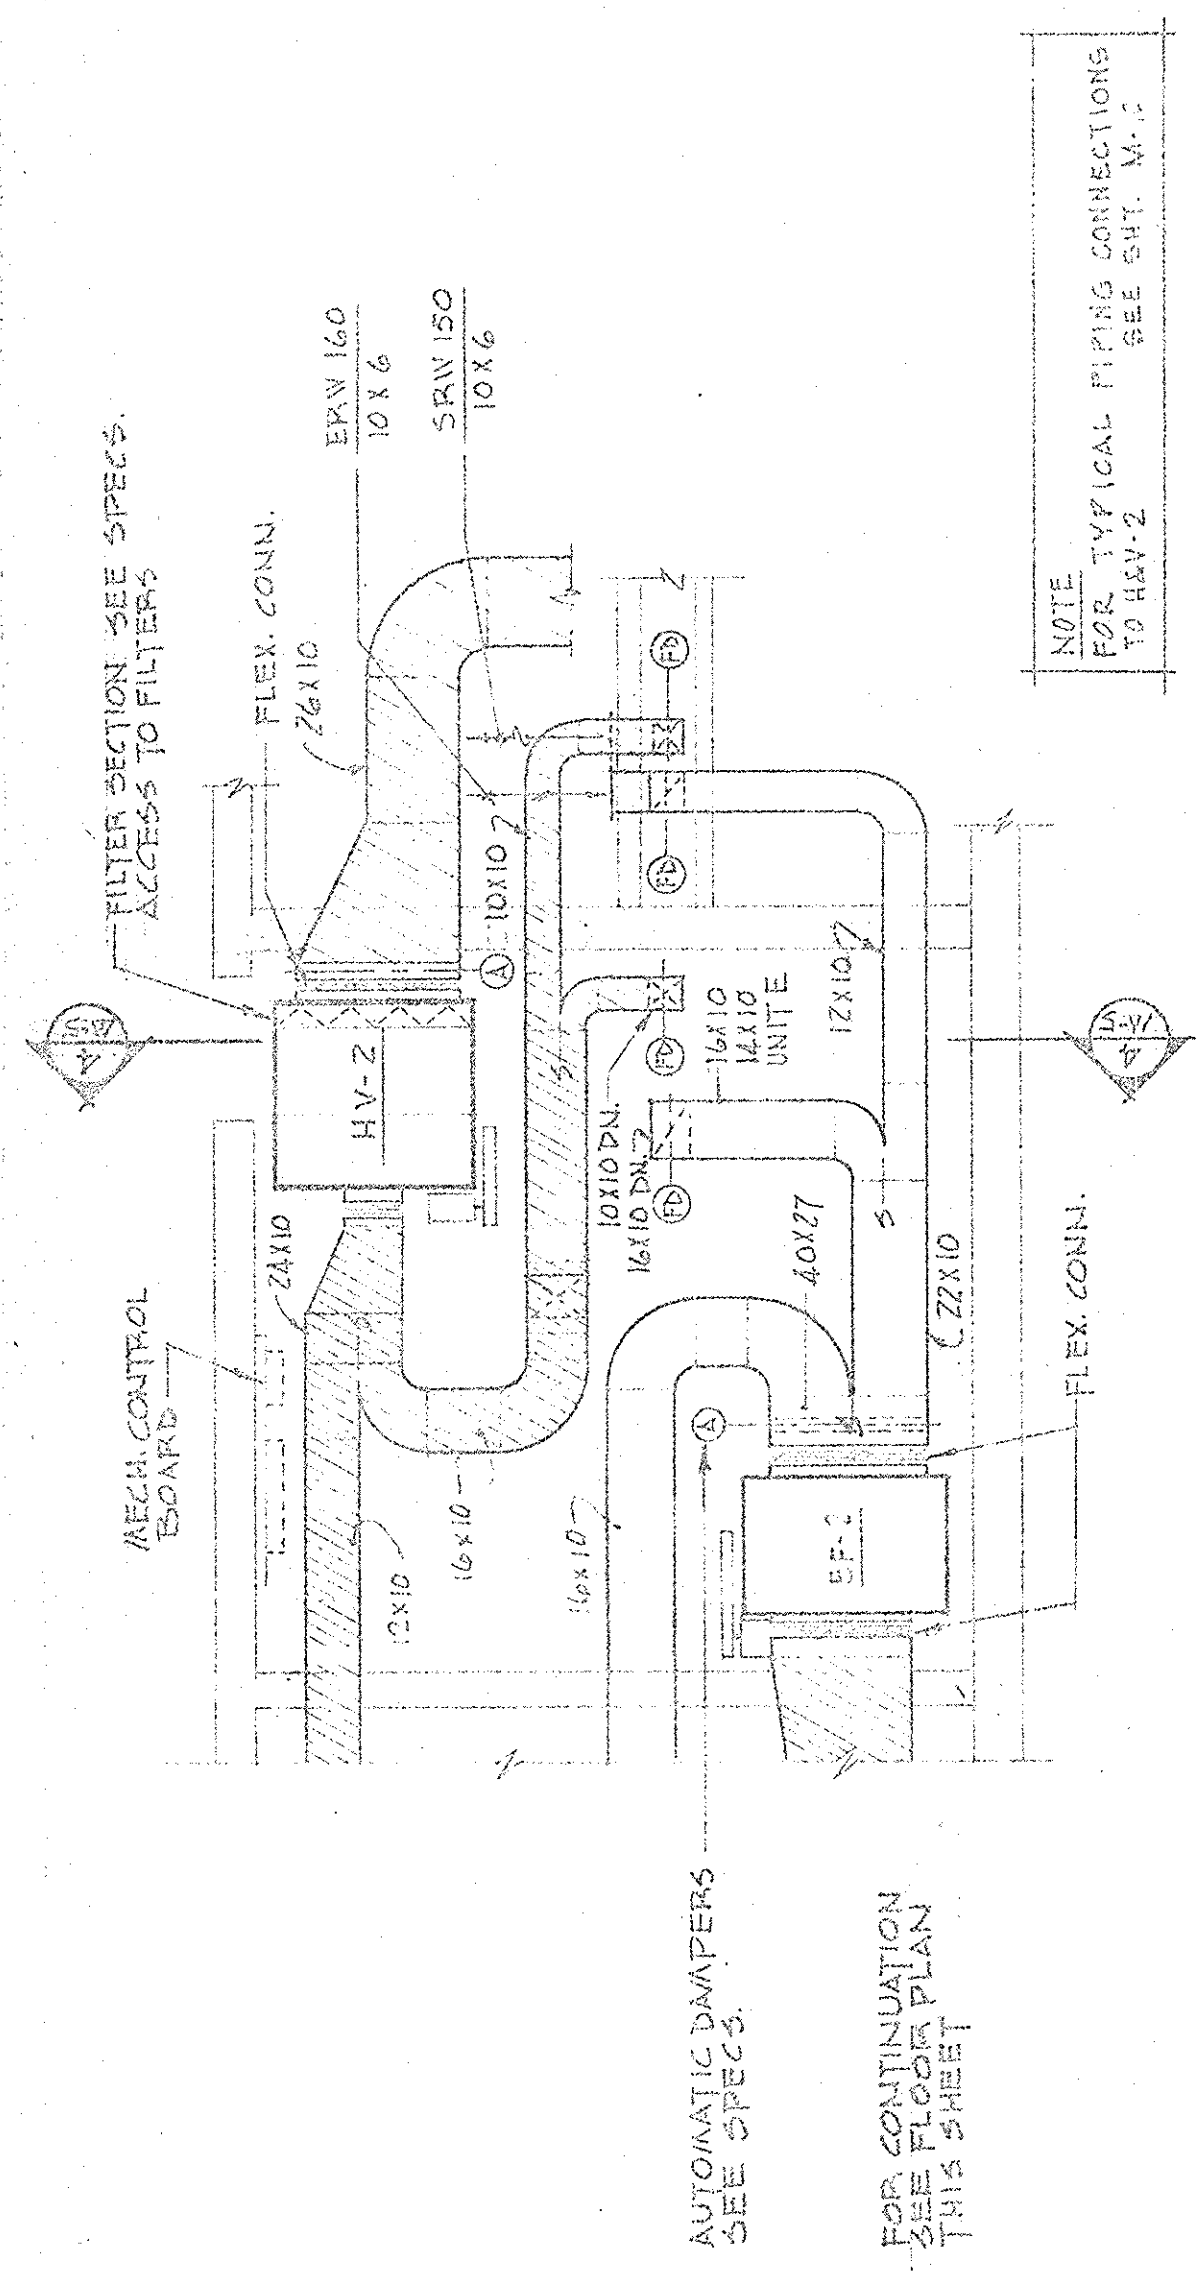

TYPICAL MECH. ROOM FLOOR PLAN—UNIT C
SCALE: 1/4" = 1'-0"

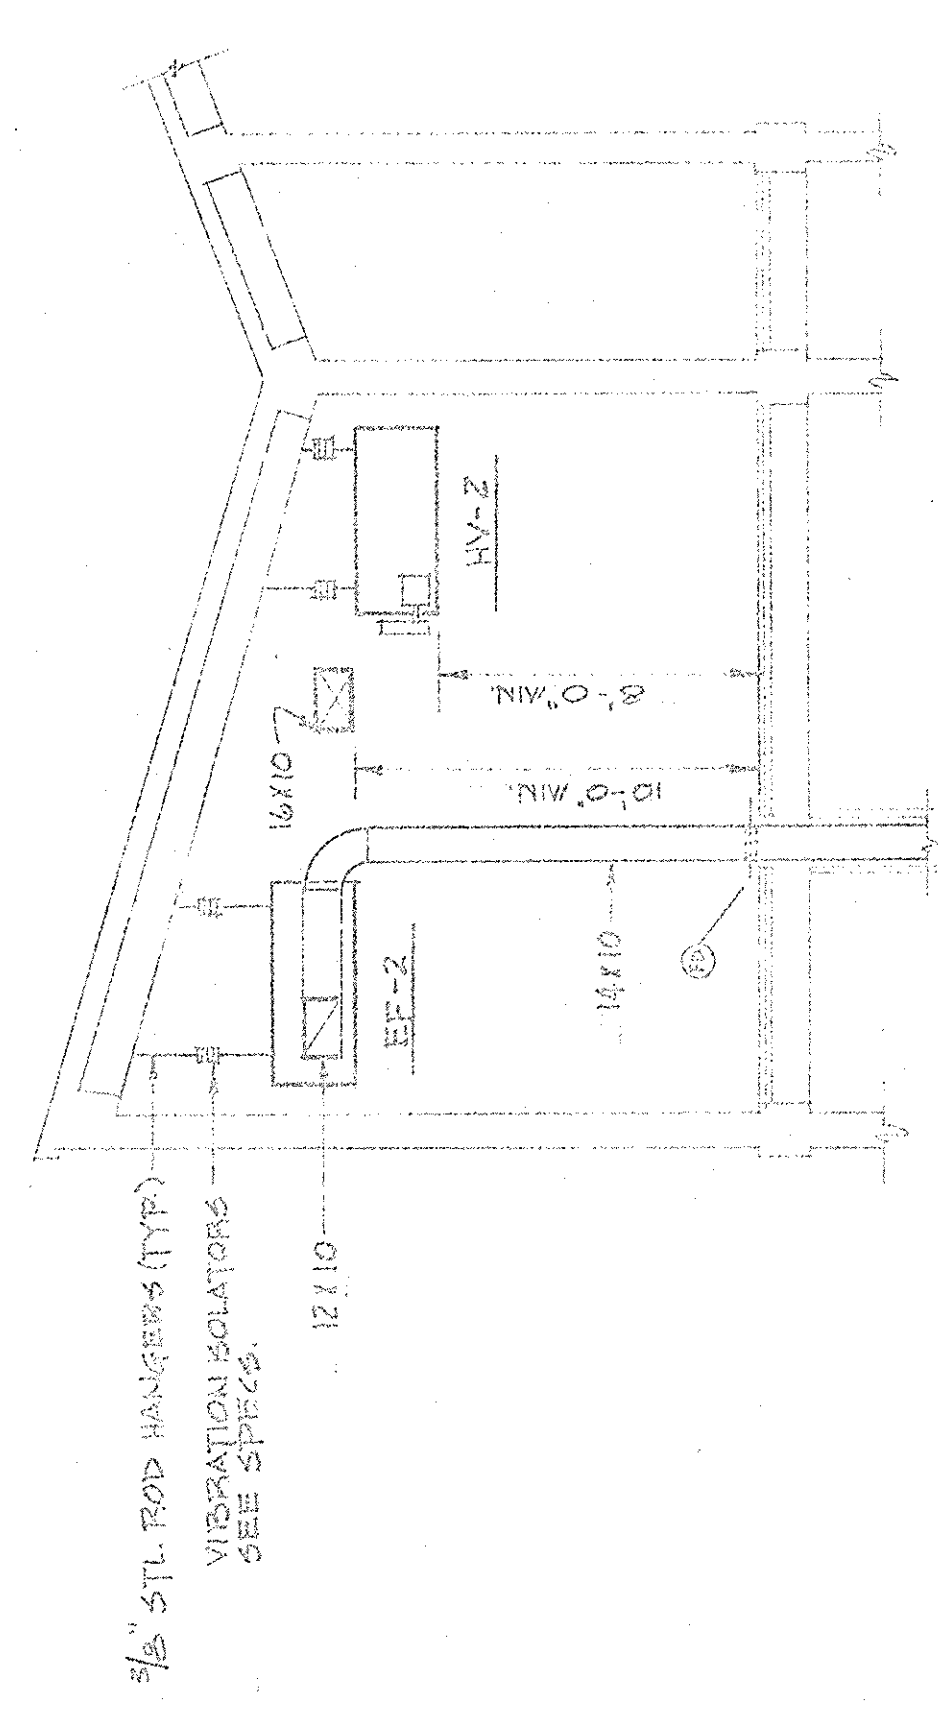

SECTION MECH. RA—UNIT C
SCALE: 1/4" = 1'-0"

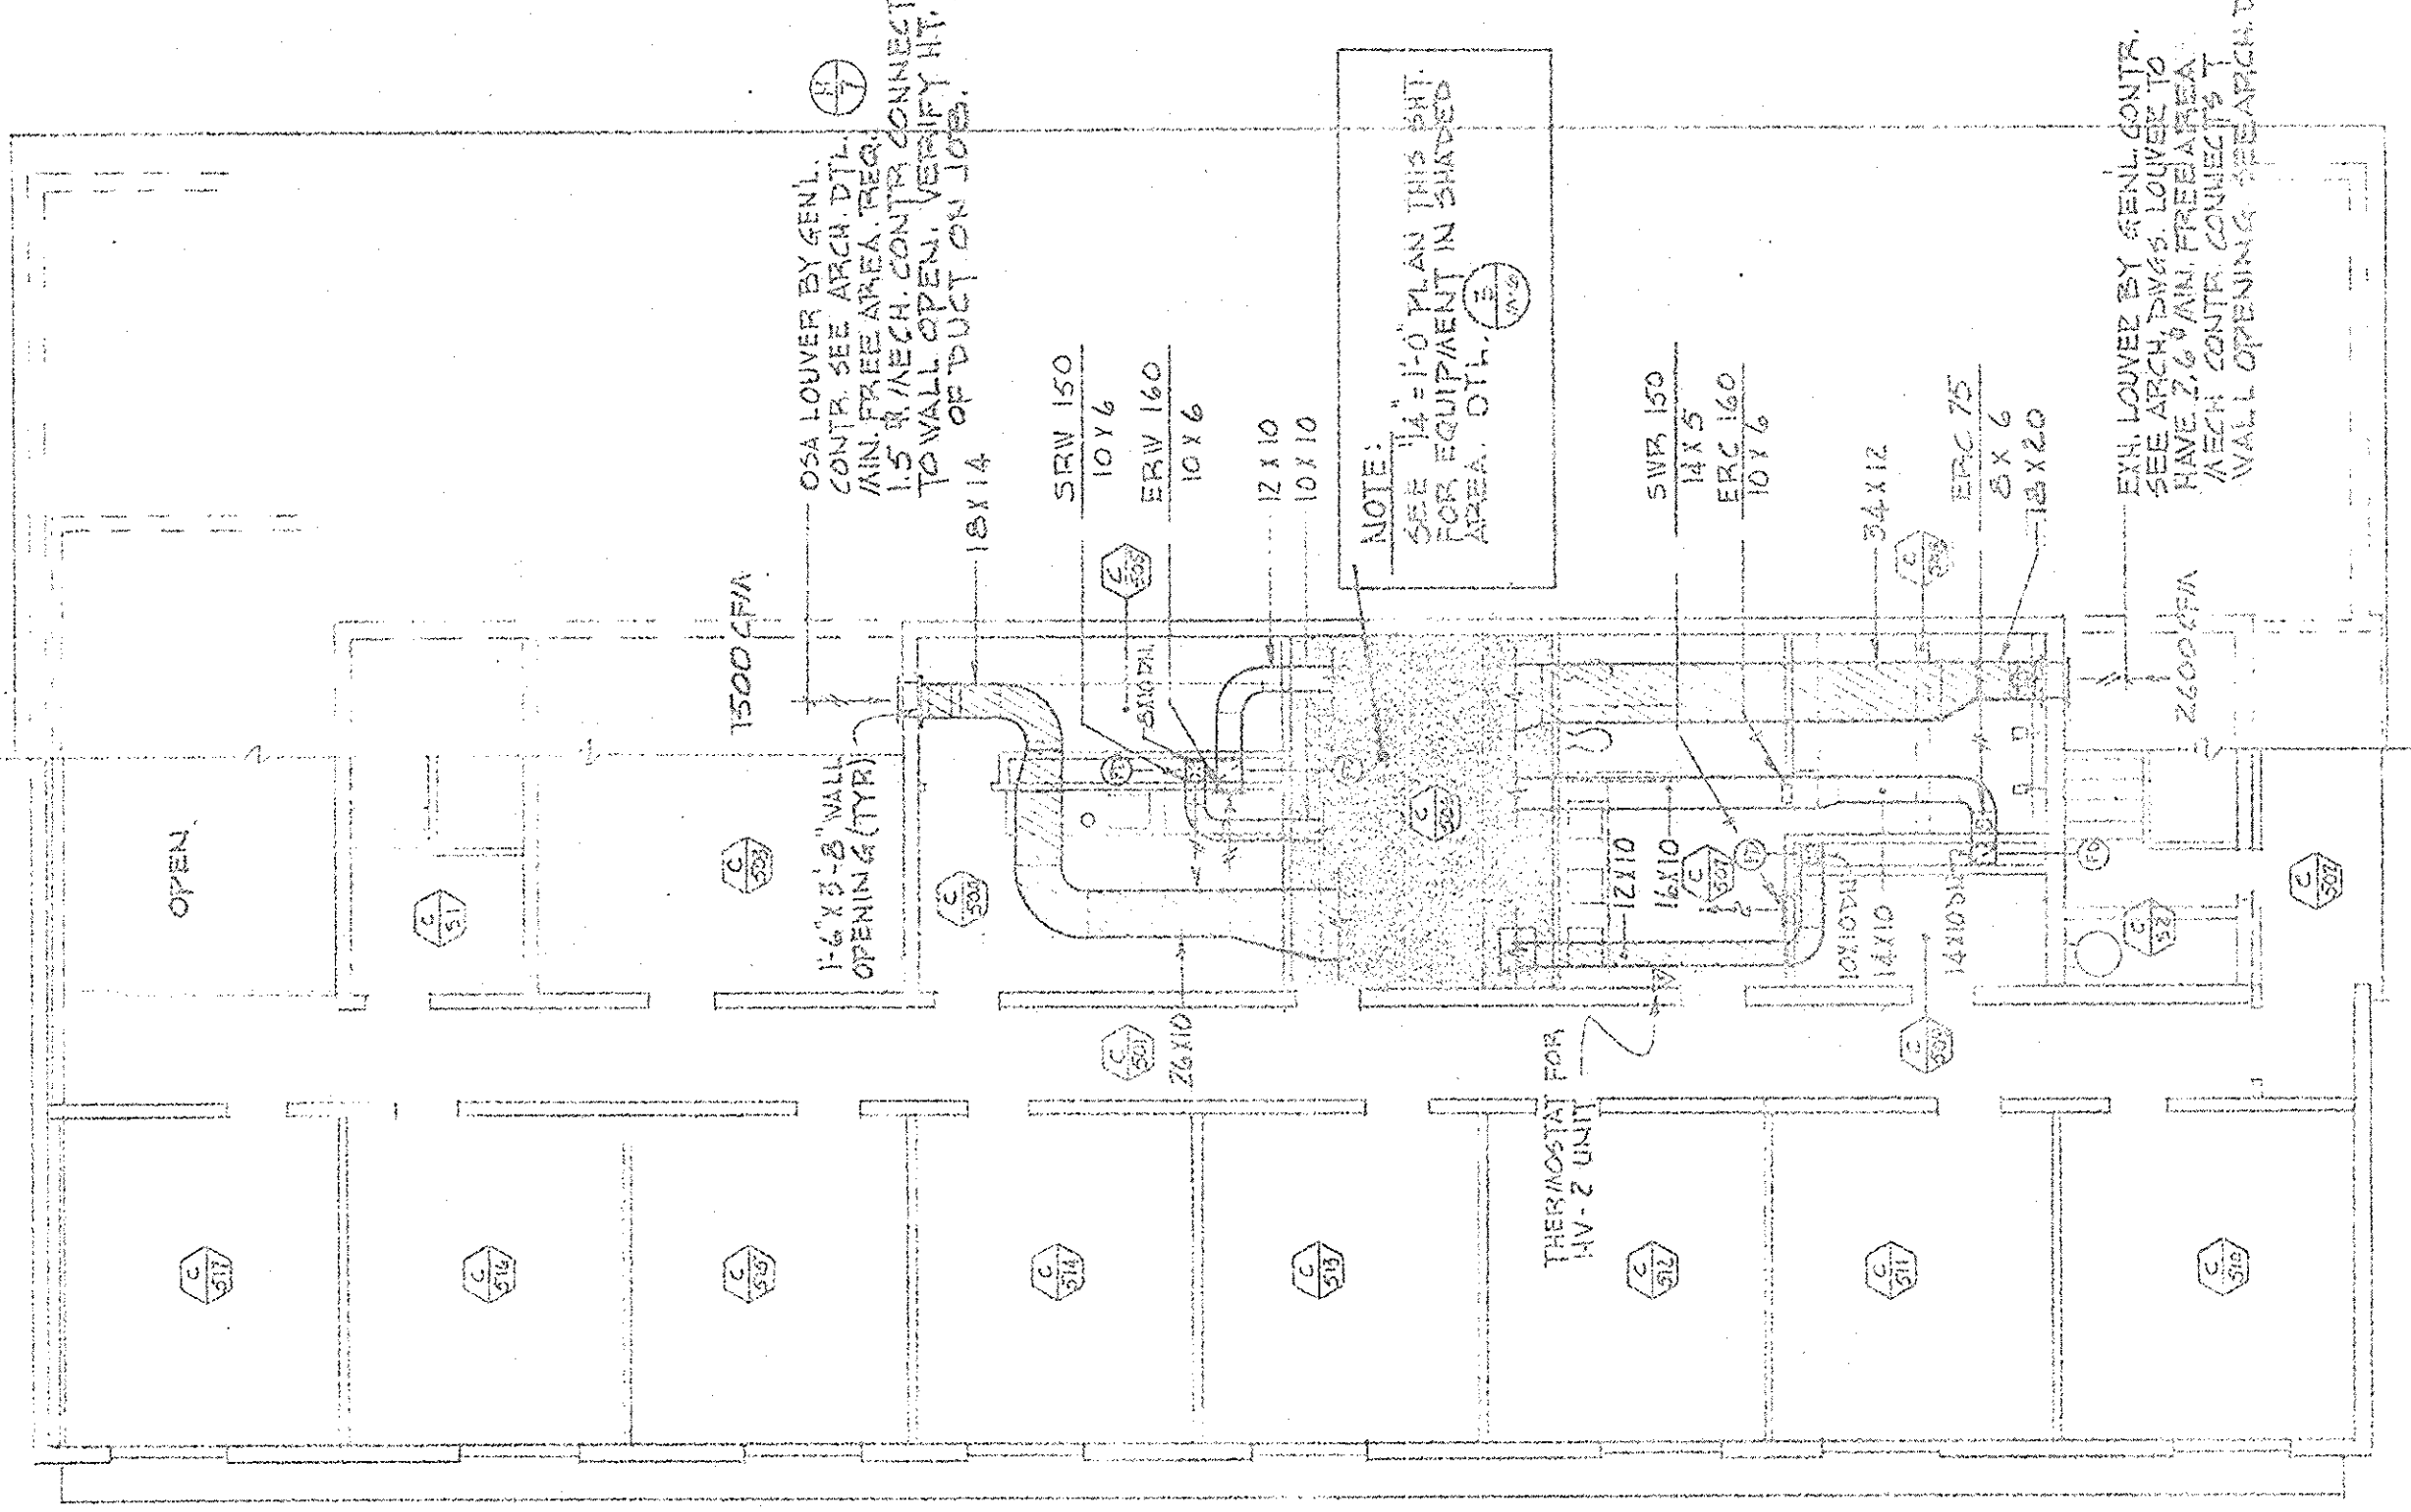

FIFTH FLOOR PLAN—UNIT C
SCALE: 1/8" = 1'-0"