



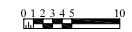

VALLEY FOOTBALL CENTER
0143 [VFBC]
725 SW 30th Street

SECOND FLOOR

SCALE:
1" = 20'-0"

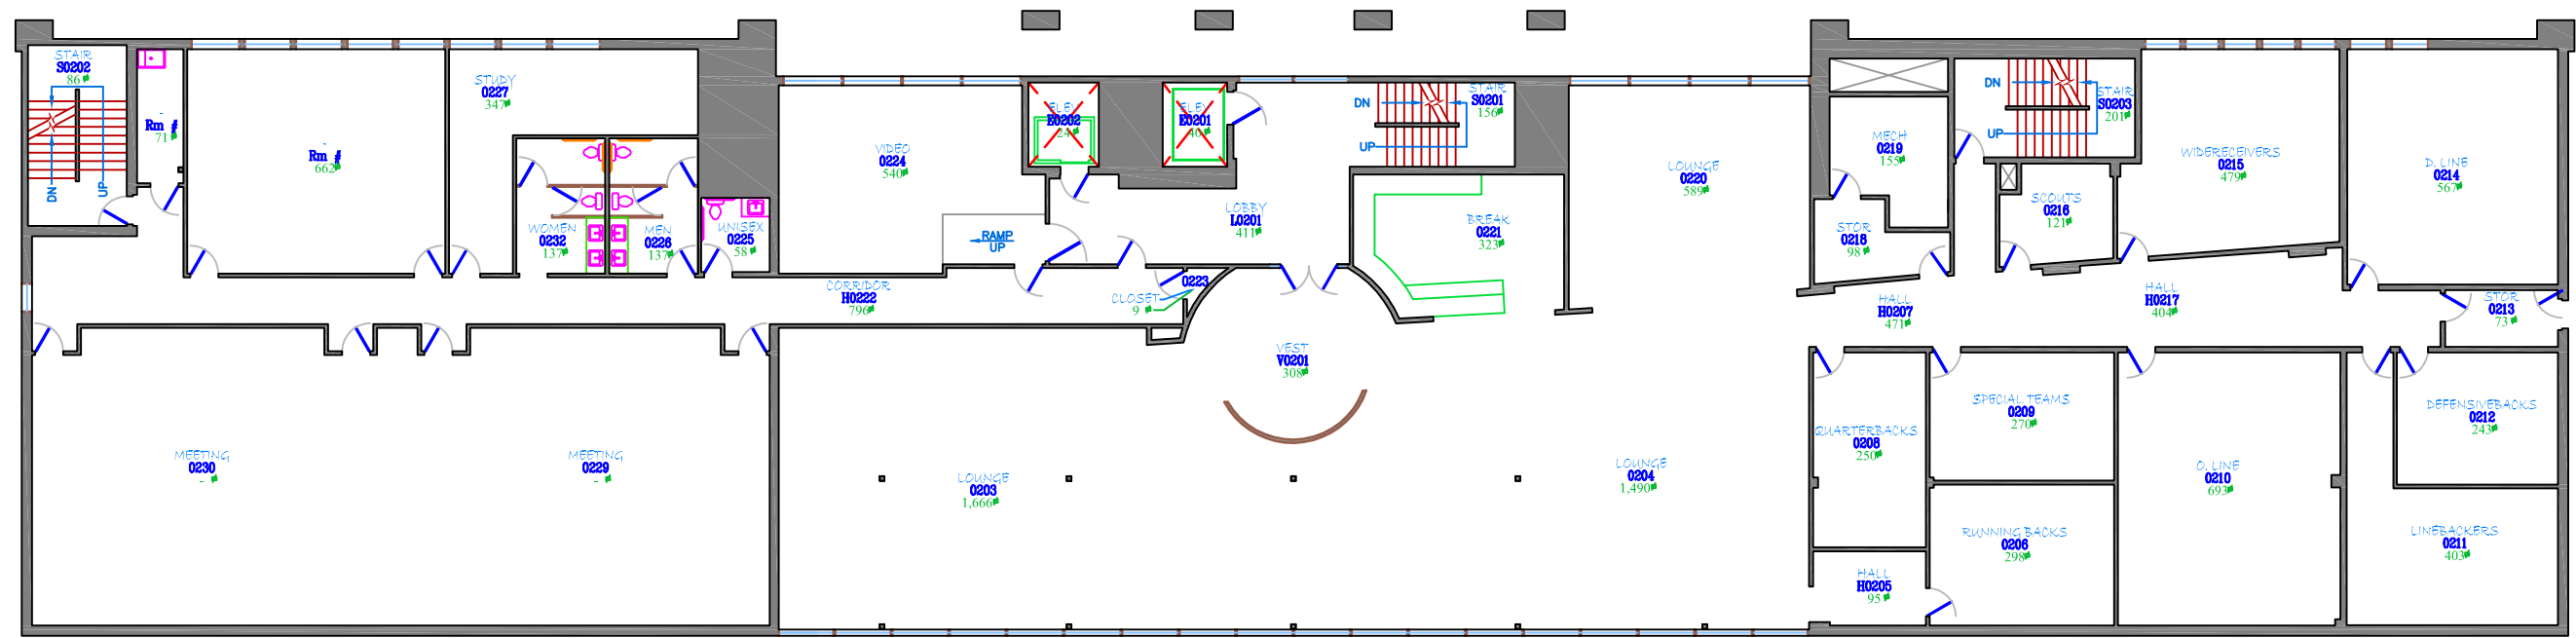

CAUTION
THIS DRAWING IS
GENERAL IN NATURE AND
IS FOR REFERENCE ONLY.

NOTE:
Project info only! not verified These are provided as general information only: The drawings were created from project drawings & information only. They have not been field verified for accuracy, completeness, or compliance to current standards. This may have an effect on OSU planners, PMs, CMs, outside contractors, or others who might use the drawing as a guide for projecting required material.

OSU FREE ACCESS INFORMATION

DATE	Drawn	QC
01/16/2014
02/11/2014
03/11/2014
04/11/2014
05/11/2014
06/11/2014
07/11/2014
08/11/2014
09/11/2014
10/11/2014
11/11/2014
12/11/2014

REVISION DESCRIPTION



NO.	REVISION DESCRIPTION
A	Standardize drawings to updated layouts. Text is TB.
B	EV-Post Survey, REVISION #7 FROM LEG DRAFTS

FACILITIES RECORD DRAWING

Swathy
 1/16/2014
 01/16/2014
 02/11/2014
 03/11/2014
 04/11/2014
 05/11/2014
 06/11/2014
 07/11/2014
 08/11/2014
 09/11/2014
 10/11/2014
 11/11/2014
 12/11/2014

SHEET # **3**
OF **4**

 File path: S:\ACAD\CAD\Bookplan\Valley_Football_Center\0143\0143_2.dwg

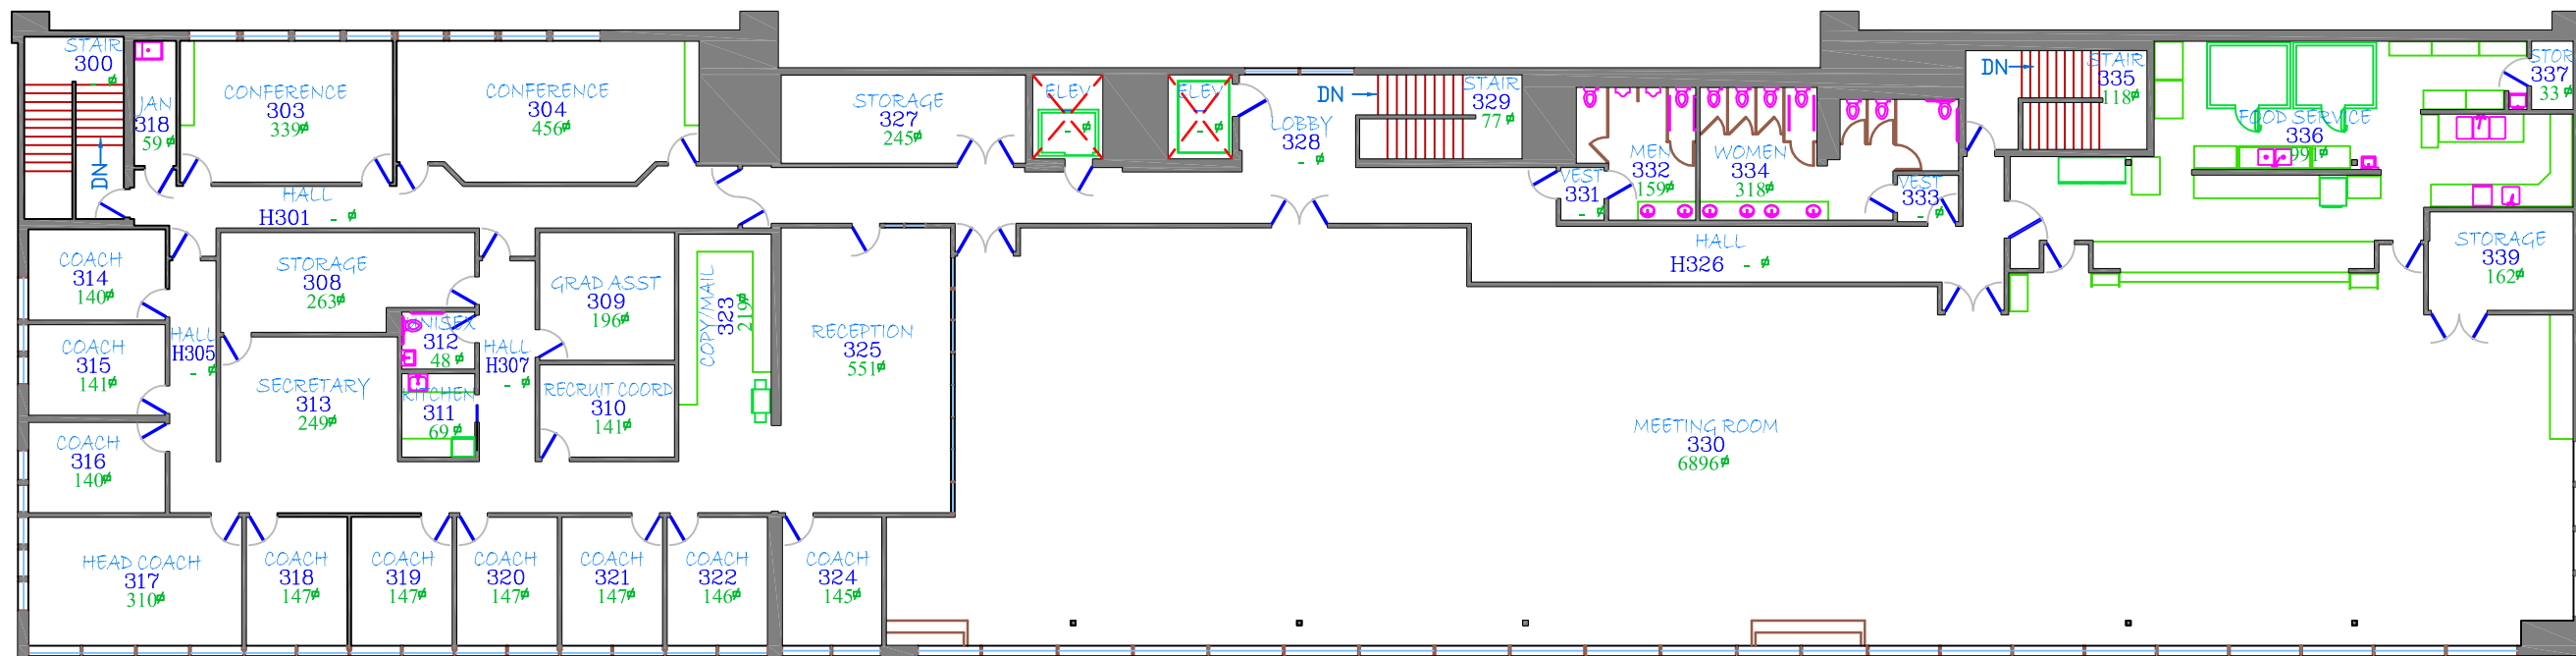

CAUTION
THIS DRAWING IS
GENERAL IN NATURE AND
IS FOR REFERENCE ONLY.



NOTE:
Project info only! not verified These are provided as general information only: The drawings were created from project drawings & information only. They have not been field verified for accuracy, completeness, or compliance to current standards. This may have an effect on OSU planners, PMs, CMs, outside contractors, or others who might use the drawing as a guide for projecting required material.

Drawing Name
0143_3



VALLEY FOOTBALL CENTER

0143 [VFBC]
725 SW 30th Street

THIRD FLOOR

SCALE:
1" = 20'-0"

OSU FREE ACCESS INFORMATION

DATE	Drawn	QC
2014.05.17	JKS	

NO.	REVISION DESCRIPTION
1	Standardized Drawing Layout, Text, & TB

FACILITIES RECORD DRAWING
Swedish Building 2014
Created: March 5, 2013
Modified: May 1, 2014
Overlaid: Landscape
Plot Scale: 0.386663
Paper Size: 11x17
Device: None
Plot Style: ...

SHEET #	4
OF	4

File path: S:\ACAD\CAD\Bookplan\Valley_Football_Center(VFBC)-0143\0143_3.dwg