



**NORTH ELEVATION**

1/16"=1'-0"

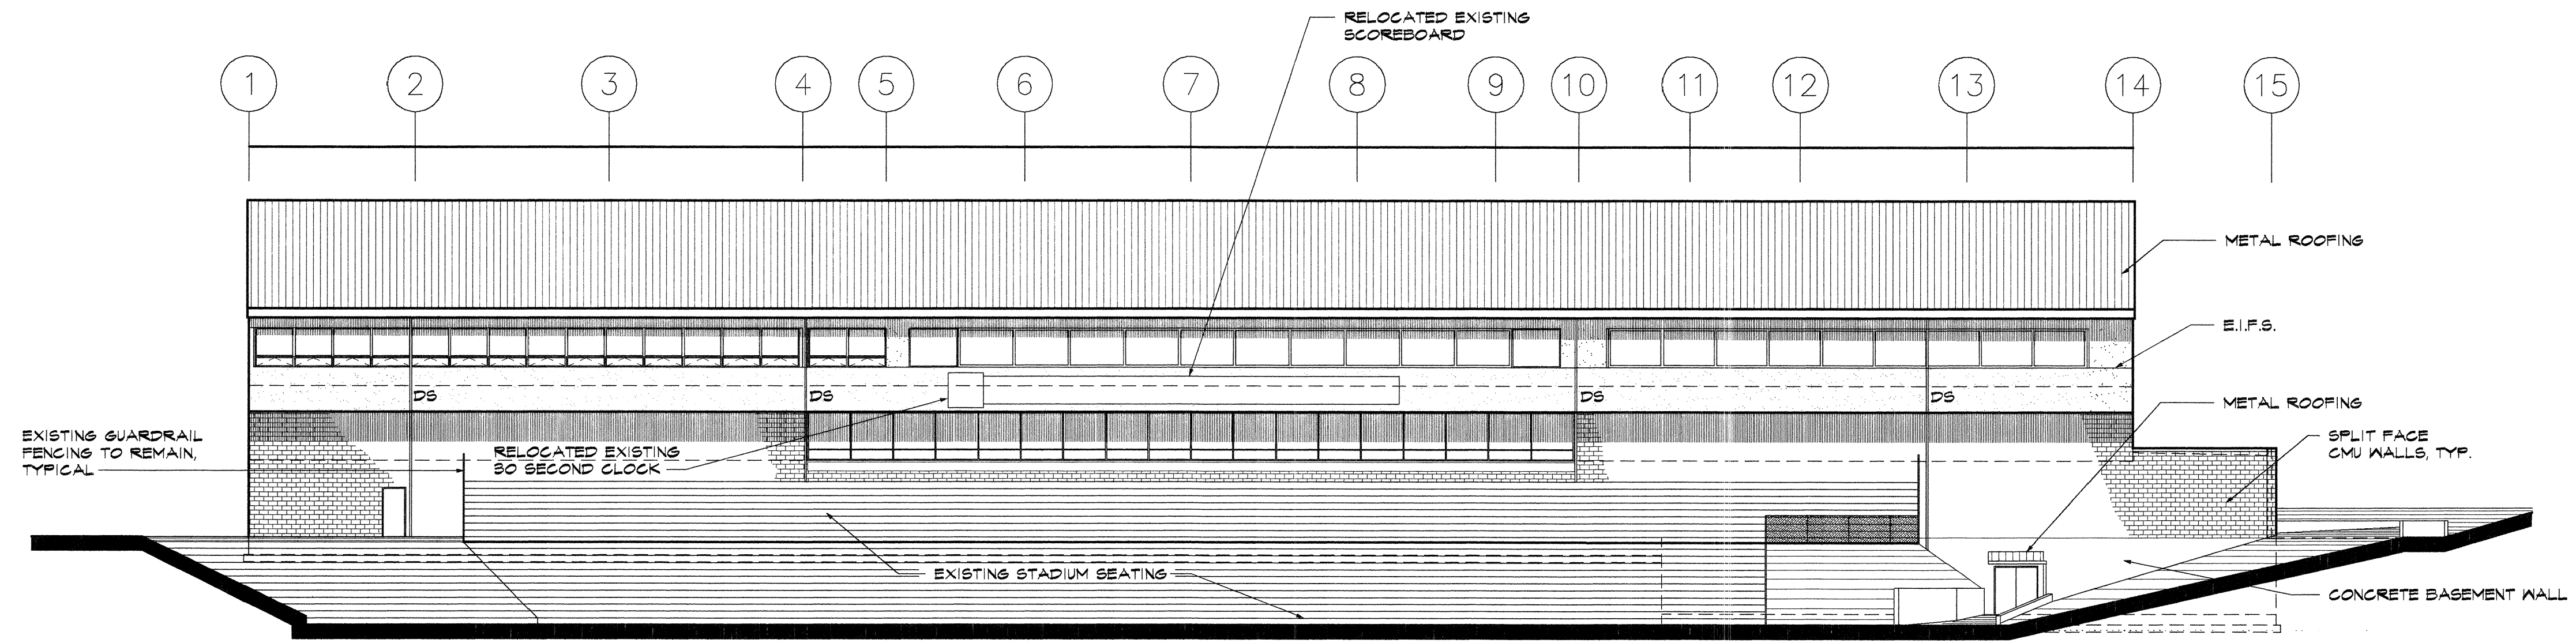


**SOUTH ELEVATION**

1/16"=1'-0"

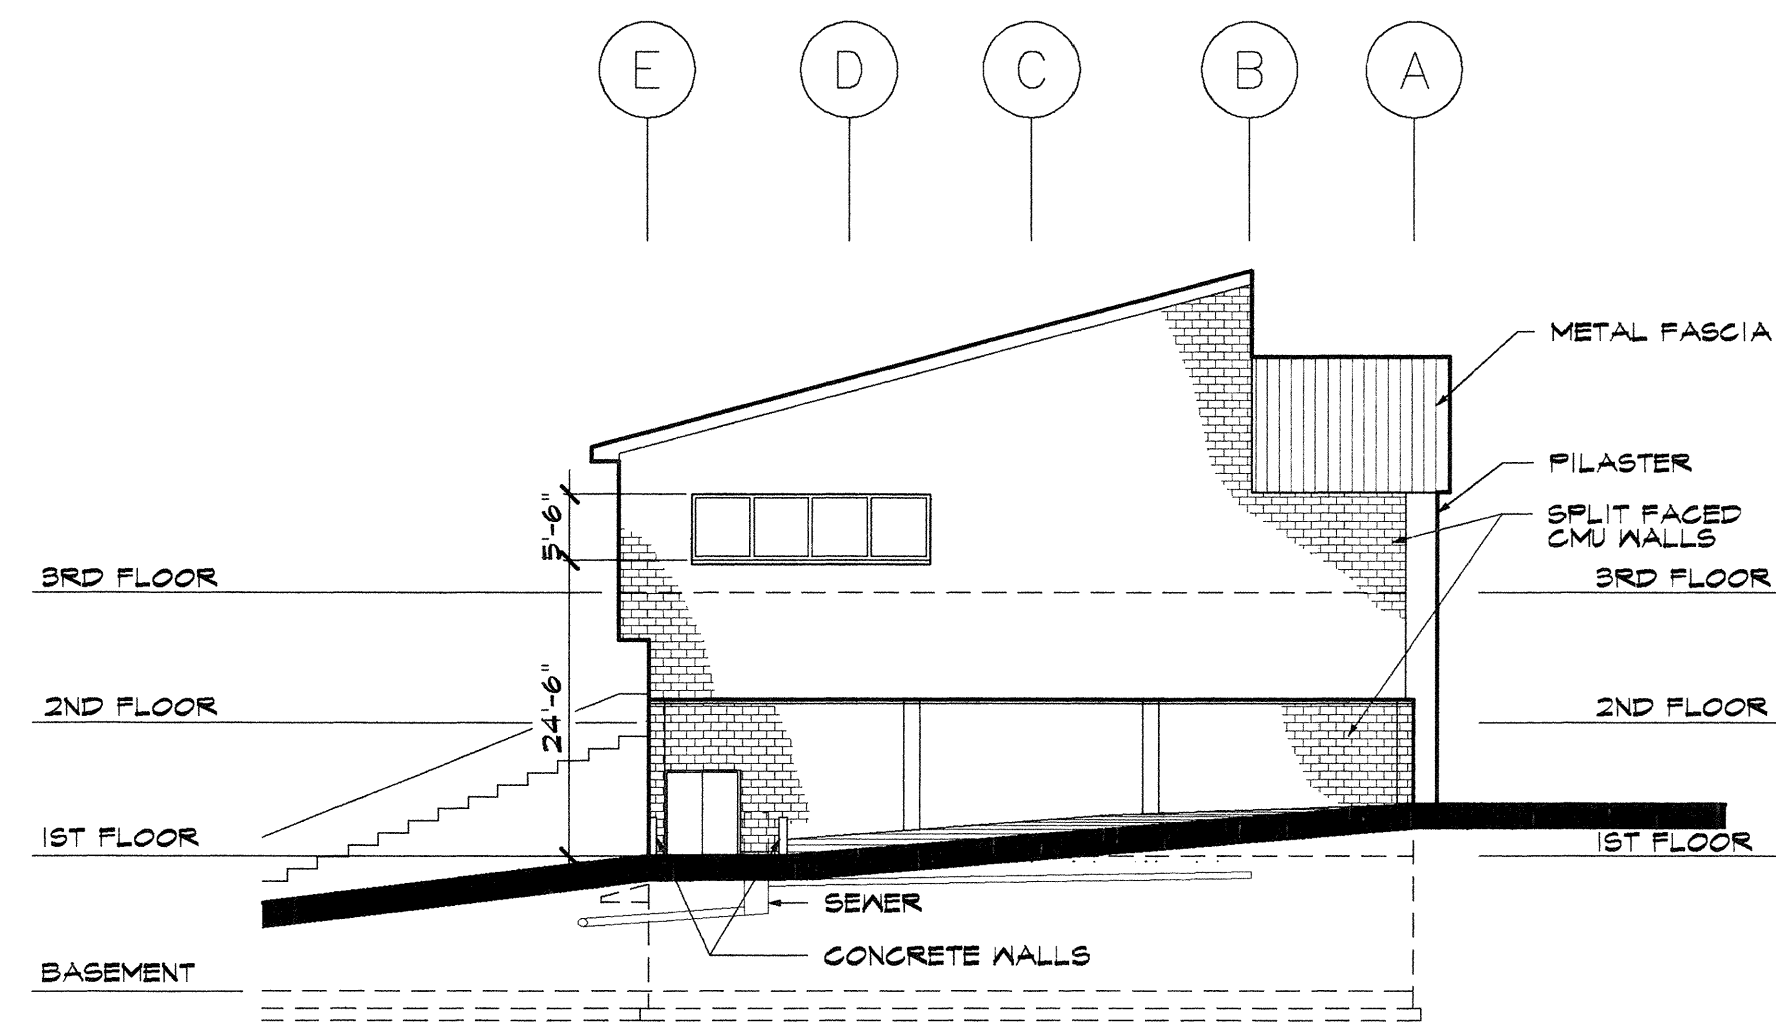

**EAST ELEVATION**

1/16"=1'-0"

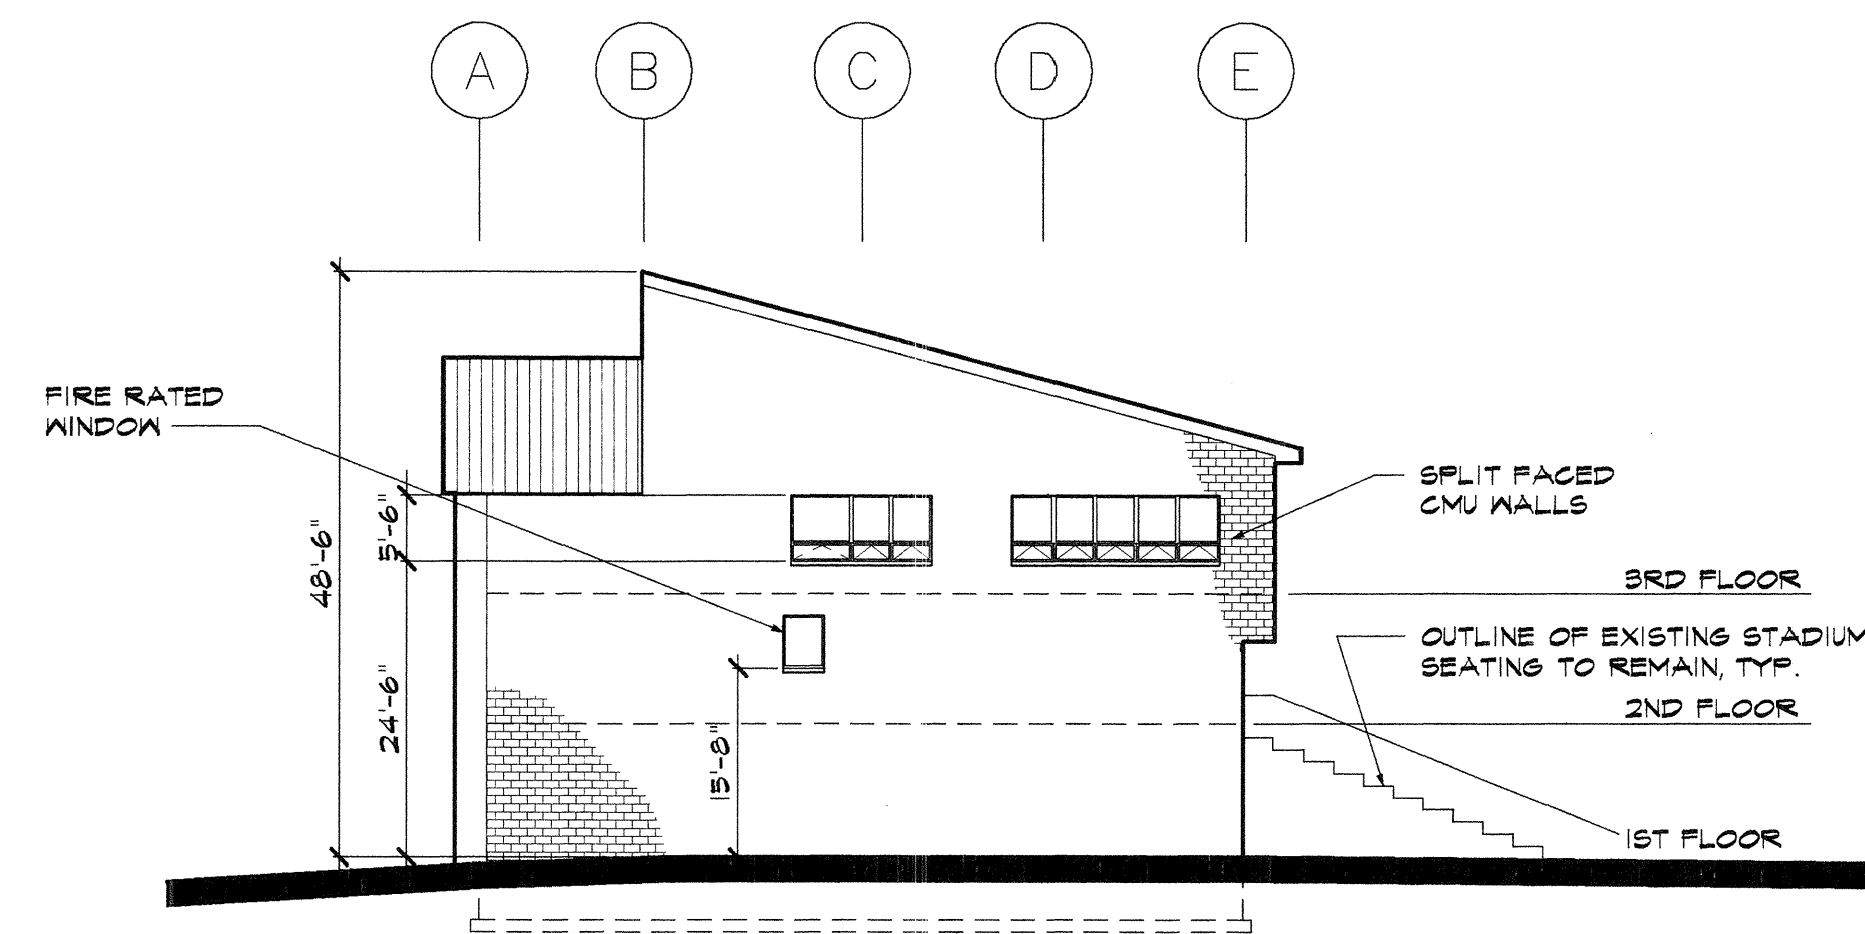

**WEST ELEVATION**

1/16"=1'-0"

**RECORD DRAWING**  
THIS IS A RECORD DRAWING PREPARED FROM INFORMATION PROVIDED BY THE CONTRACTOR OF RECORD. THIS DRAWING TO BE USED FOR THE PURPOSE OF MAINTENANCE OF THE FACILITY FOR WHICH IT WAS PREPARED AND NOT FOR CONSTRUCTION.  
DATE: JUNE 14, 1997

revisions  
**carlson/veit architects p.c.**  
members american institute of architects  
3095 river road north, salem, oregon 97303 phone 503 390-0281

**EXTERIOR ELEVATIONS**  
ADD/ALTER:  
**VALLEY FOOTBALL CENTER**  
OREGON STATE UNIVERSITY  
O.S.U. BEAVER CLUB  
GILL COLISEUM 123, CORYALLIS, OR 97331

date 4-9-96  
project  
drawn by 0245  
checked by CP/RVC  
CV

sheet  
**A3.5**  
of 50



DRAWING NUMBER

DRAWING NUMBER

DRAWING NUMBER

