
OOG RECORD SET

19,

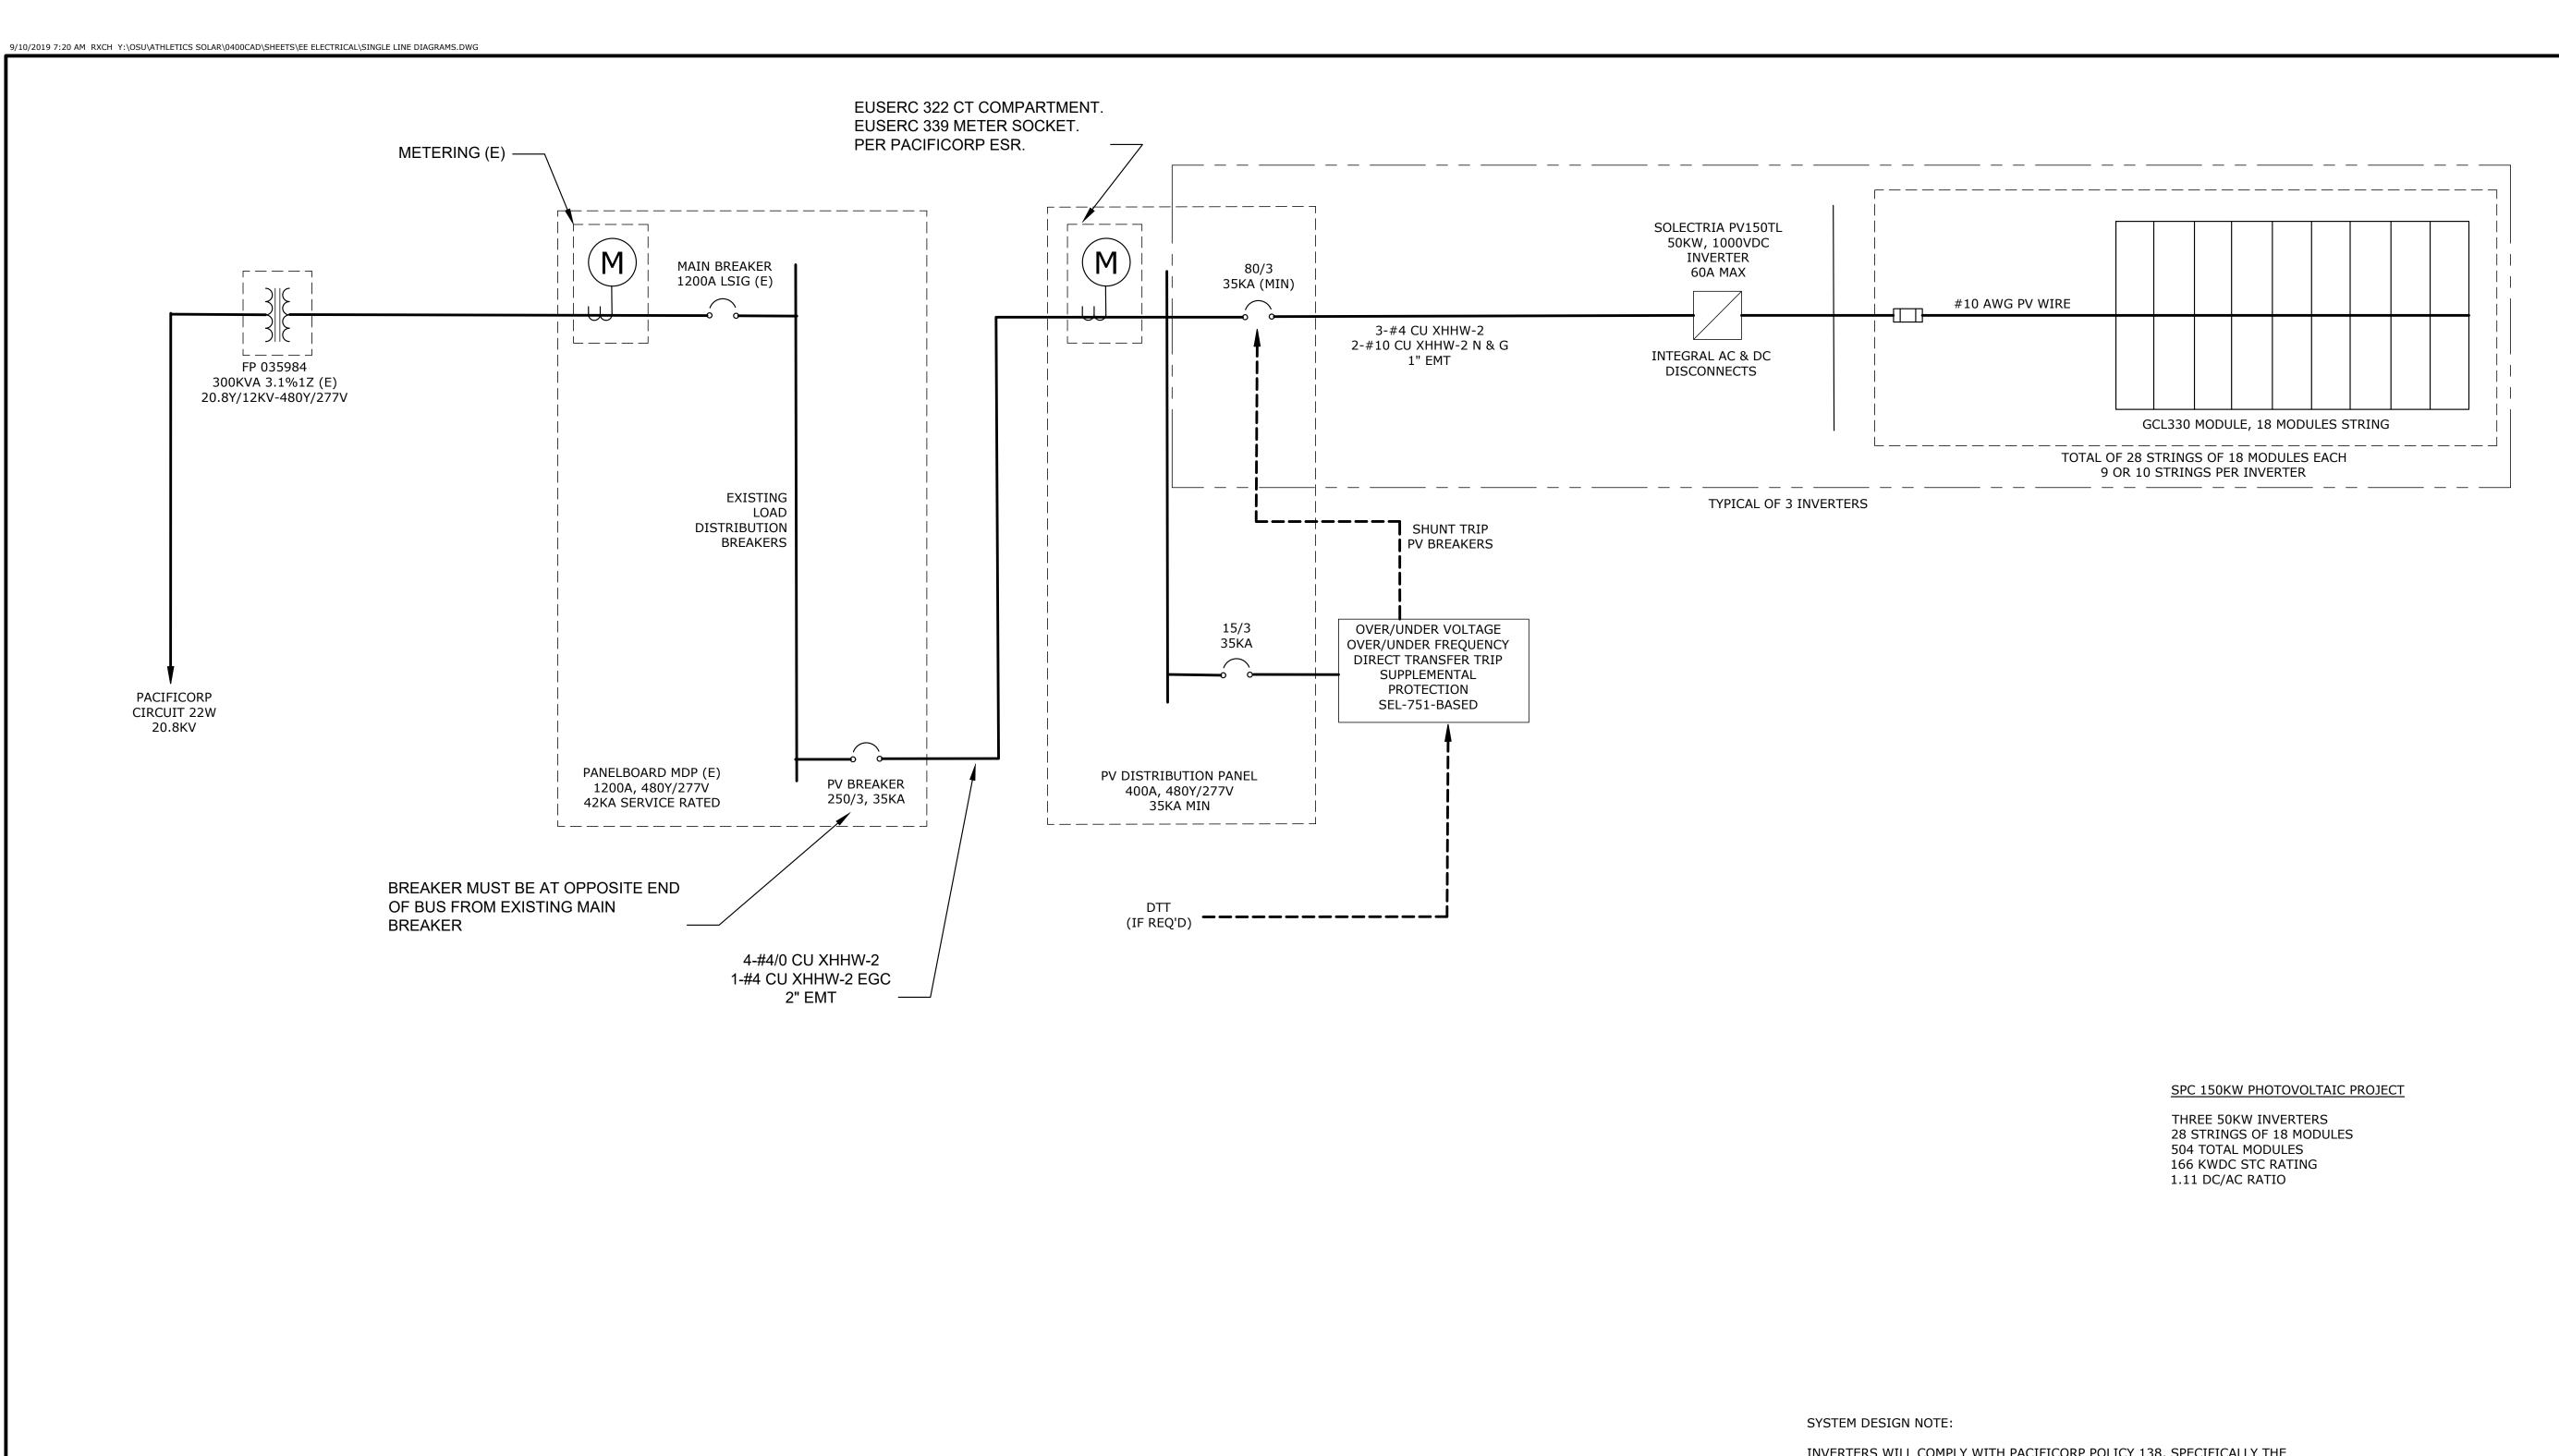

INVERTERS WILL COMPLY WITH PACIFICORP POLICY 138, SPECIFICALLY THE REQUIREMENT FOR COMPLIANCE WITH IEEE 1547-2018 7.4.2 FOR TOV.

WILLAMETTE
POWER
ENGINEERING

TriAxis
A DIVISION OF
DAVID EVANS AND ASSOCIATES

							DESIGNED BY:	M BEANLAND	DATE:	SEP 2019	
ŀ							DRAFTED BY:	R HAMMEL	DRAWING NO.:	SINGLE LINE DIAGRAMS	
.							CHECKED BY:	M ANTONISHEN	PROJECT NO.:	ORSU0000-8101	
	Α	09/09/19	PREMILINARY	RCH	MB	MB					l
	NO.	DATE	REVISION	DR	BY	APVD	APPROVED BY:	M BEANLAND	REVISION NO.: A	Α	