

**Field Verification NOTE:**  
 Preference in accuracy was given to the interior room areas and shapes, not the thickness of walls or structural features. This may have an effect on OSU planners, PMs, CMs, outside contractors, or others who might use the drawing as a guide for projecting required material, open penetration areas, or other regular information taken from CAD drawings. This is a Legacy issue that is nearly impossible to fix at this point of the buildings life especially as it is occupied.

**CAUTION**  
 THIS DRAWING IS  
 GENERAL IN NATURE AND  
 IS FOR INFORMATION ONLY

ROOM	LOCATION TYPE
0104	ElevMech

End of chart


**OSU FREE ACCESS INFORMATION**

DATE	Drawn	OC
10.04.13	EAS	VCF

REVISION DESCRIPTION  
 A Field verification updates & prepped for AM-CAD integration

FACILITIES RECORD DRAWING  
 Saved by: meo/ab  
 last saved: October 27, 2017  
 Created: October 27, 2017  
 Plot date: August 19, 2019  
 Operator: Landscape  
 Plot name: 0156.dwg  
 Plot device: 0156.plt  
 Plot date: ---

SHEET # **1**  
 OF **5**

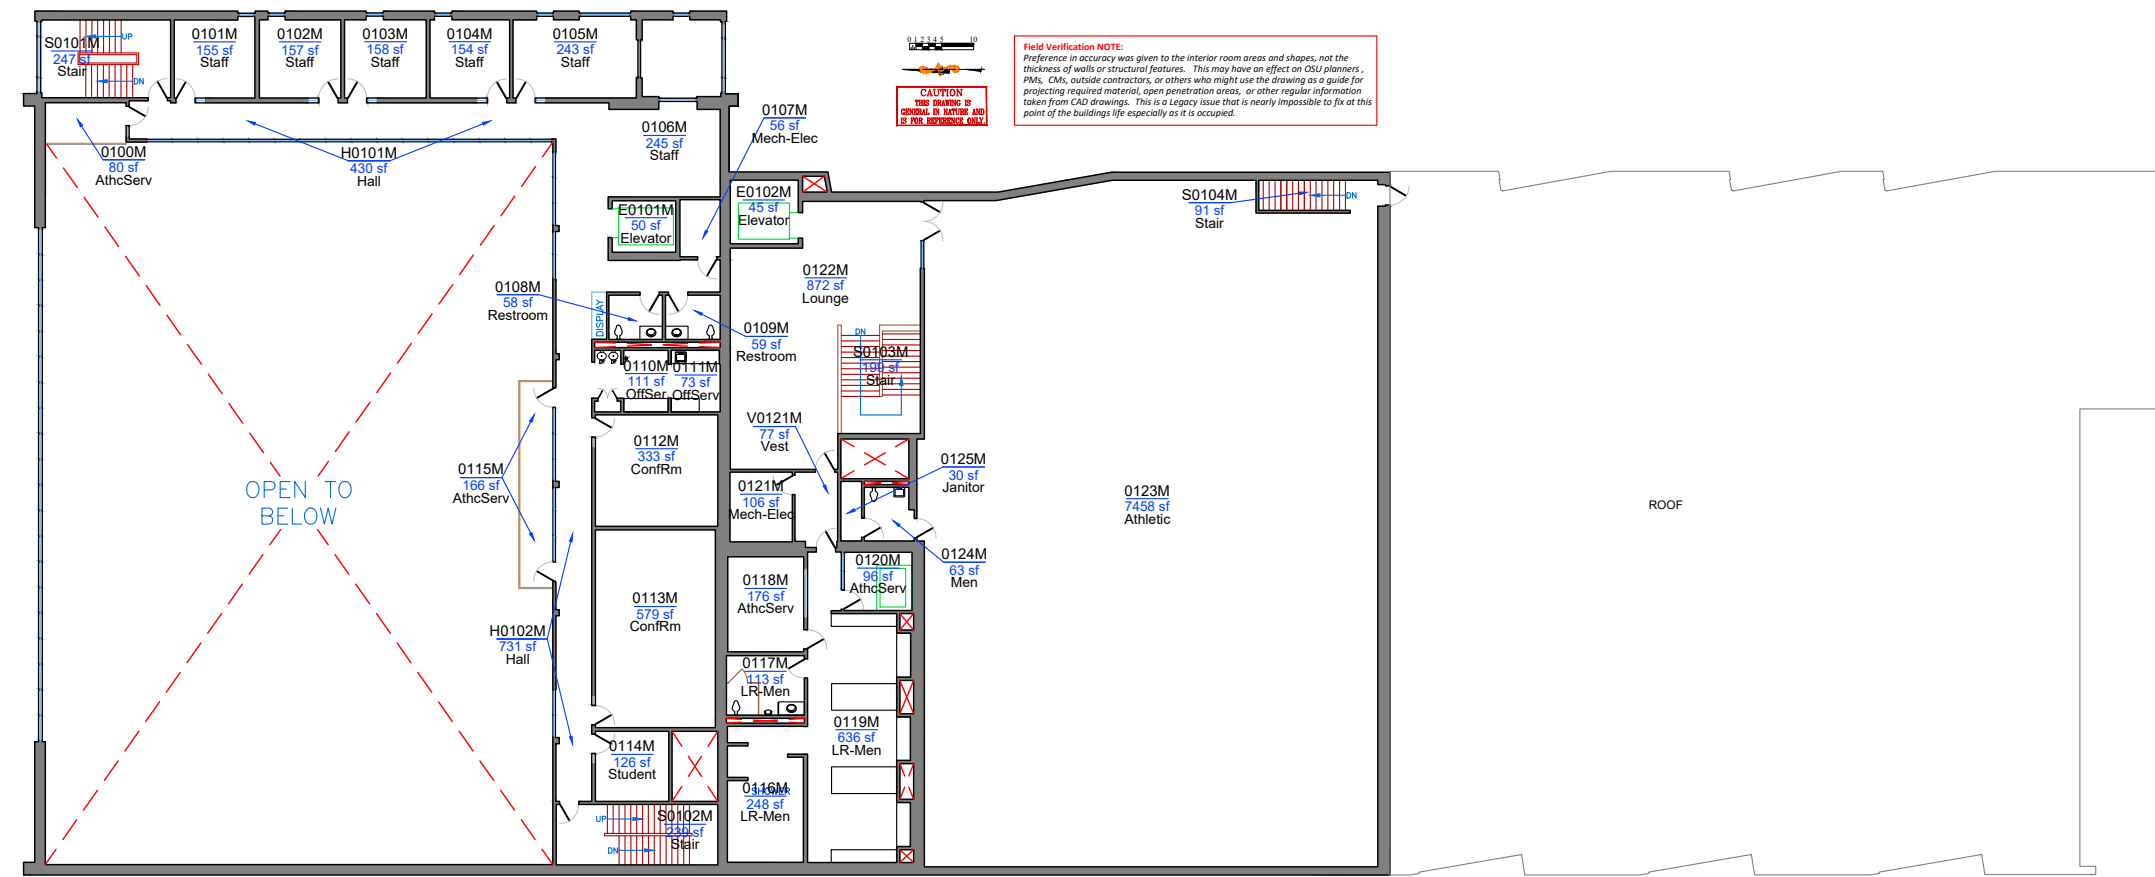

**Field Verification NOTE:**  
Preference in accuracy was given to the interior room areas and shapes, not the thickness of walls or structural features. This may have an effect on CSI planners, PMs, CMs, outside contractors, or others who might use the drawing as a guide for projecting required material, open penetration areas, or other regular information taken from CAD drawings. This is a legacy issue that is nearly impossible to fix at this point of the buildings life especially as it is occupied.

**CAUTION**  
THIS DRAWING IS GENERAL IN NATURE AND IS FOR REFERENCE ONLY.

ROOM	LOCATION TYPE
0110M	OffServ


End of chart

OSU FREE ACCESS INFORMATION

DATE	DATE	DESCRIPTION
10-4-2015	EAS	Field Verified and ready to be loaded into AIA.

FACILITIES RECORD DRAWING  
 Saved by: meolab  
 last saved: October 27, 2017  
 Created: October 27, 2017  
 Modified: August 19, 2019  
 Operator: Landscape  
 Plot device: User Defined  
 Plot style: User Defined  
 Page: None  
 Plot set up: ...

SHEET #: 2  
 OF: 5

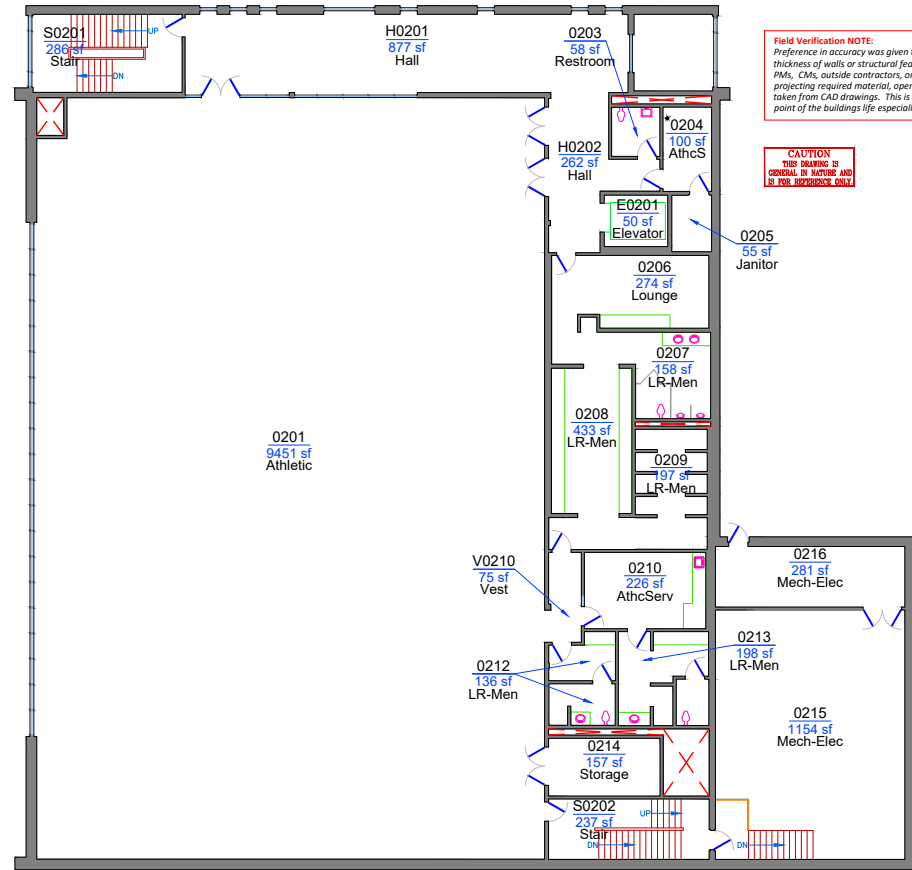

**Field Verification NOTE:**  
 Preference in accuracy was given to the interior room areas and shapes, not the thickness of walls or structural features. This may have an effect on OSU planners, PMs, CMs, outside contractors, or others who might use the drawing as a guide for projecting required material, open penetration areas, or other regular information taken from CAD drawings. This is a legacy issue that is nearly impossible to fix at this point of the building's life especially as it is occupied.

**CAUTION**  
 THIS DRAWING IS  
 GENERAL IN NATURE AND  
 IS FOR INFORMATION ONLY



ROOM	LOCATION TYPE
0204	AthcServ

End of chart

**OSU FREE ACCESS INFORMATION**

Drawing Name  
**0156\_2**



**Oregon State  
 University**

**SPORTS PERFORMANCE  
 CENTER  
 0156 (SPC)  
 2737 SW RALPH MILLER LANE**


**SECOND  
 FLOOR**

SCALE:  
**1" = 30'-0"**

DATE	DESCRIPTION	BY
10-24-2019	EAS	

**FACILITIES RECORD DRAWING**  
 Saved by: meadlab  
 last saved: October 27, 2017  
 Created: October 27, 2017  
 Modified: August 19, 2019  
 Operation: Landscape  
 Plot Date: 10/27/17  
 Plot Name: 0156\_2.dwg  
 Plot Date: 10/27/17  
 Plot Size: 11x17  
 Plot Setup: ...

SHEET # **3**  
 OF **5**

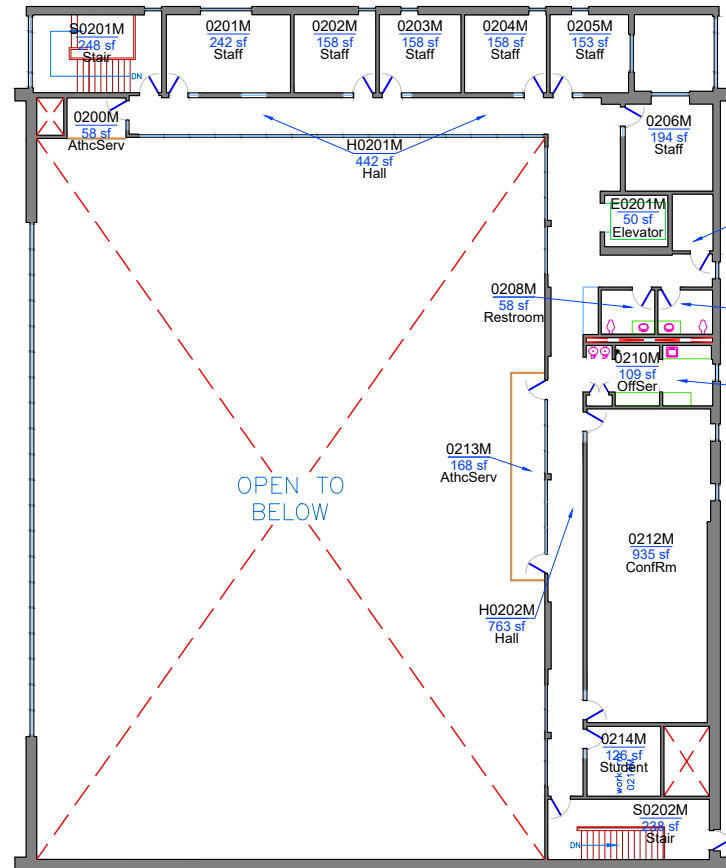

**Field Verification NOTE:**  
 Preference in accuracy was given to the interior room areas and shapes, not the thickness of walls or structural features. This may have an effect on OSU planners, PMs, CMs, outside contractors, or others who might use the drawing as a guide for projecting required material, open penetration areas, or other regular information taken from CAD drawings. This is a Legacy issue that is nearly impossible to fix at this point of the building's life especially as it is occupied.

**CAUTION**  
 THIS DRAWING IS GENERAL IN NATURE AND IS FOR REFERENCE ONLY.



ROOM	LOCATION TYPE
0210M	OffServ

End of chart

**OSU FREE ACCESS INFORMATION**

Drawing Name  
**0156\_2M**

**Oregon State University**

**SPORTS PERFORMANCE CENTER**  
**0156 (SPC)**  
**2737 SW RALPH MILLER LANE**

**FIRST FLOOR**

SCALE:  
**1" = 30'-0"**

DATE	DESCRIPTION	BY
10-24-2015	EAS	

**REVISION RECORD DRAWING**

**REVISION DESCRIPTION**

 
A Field Verification and ready to be loaded into AIM.

**FACILITIES RECORD DRAWING**


Drawn by: meadlab  
 Date saved: October 27, 2017  
 Created: October 27, 2017  
 Plot date: August 19, 2019  
 Operator: Landscape  
 Plot device: US:HPGL  
 Plot style: US:HPGL.ctb  
 Plot setup: ...

**SHEET #:** 4  
**OF:** 4

File path: S:\ACAD\CAD\Bookplan\Sport\_Performance\_Center(SPC)-0156\0156\_2M.dwg



ROOF

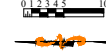

**CAUTION**  
THIS DRAWING IS  
GENERAL IN NATURE AND  
IS FOR REFERENCE ONLY.

**Field Verification NOTE:**  
Preference in accuracy was given to the interior room areas and shapes, not the thickness of walls or structural features. This may have an effect on OSU planners, PMs, CMs, outside contractors, or others who might use the drawing as a guide for projecting required material, open penetration areas, or other regular information taken from CAD drawings. This is a Legacy issue that is nearly impossible to fix at this point of the buildings life especially as it is occupied.

**OSU FREE ACCESS INFORMATION**

Drawing Name  
**0156\_3R**



**Oregon State  
University**

**SPORTS PERFORMANCE  
CENTER  
0156 (SPC)  
2737 SW RALPH MILLER LANE**

**ROOF  
FLOOR**

SCALE:  
**1" = 24'-0"**

FACILITIES RECORD DRAWING	REVISION DESCRIPTION	DATE	Drawn	OC
Saved by: Jedsen last saved: November 15, 2013 Created: July 13, 2014 Plot date: August 19, 2019 Operator: Landscape Plot device: HP DesignJet 5000 Plot date: 11/15/13 Plot set up: ...	A Proto drawing	11-15-13	VCF	

SHEET # **5**  
OF **5**