




CAUTION
 THE DRAWING IS
 ORIGINAL. IS NOT FOR
 12 FOR REVISIONS ONLY

Field Verification NOTE:
 Preference in accuracy was given to the interior room areas and shapes, not the thickness of walls or structural features. This may have an effect on OSU planners, PMs, CMs, outside contractors, or others who might use the drawing as a guide for projecting required material, open penetration areas, or other regular information taken from CAD drawings. This is a Legacy issue that is nearly impossible to fix at this point of the buildings life especially as it is occupied.

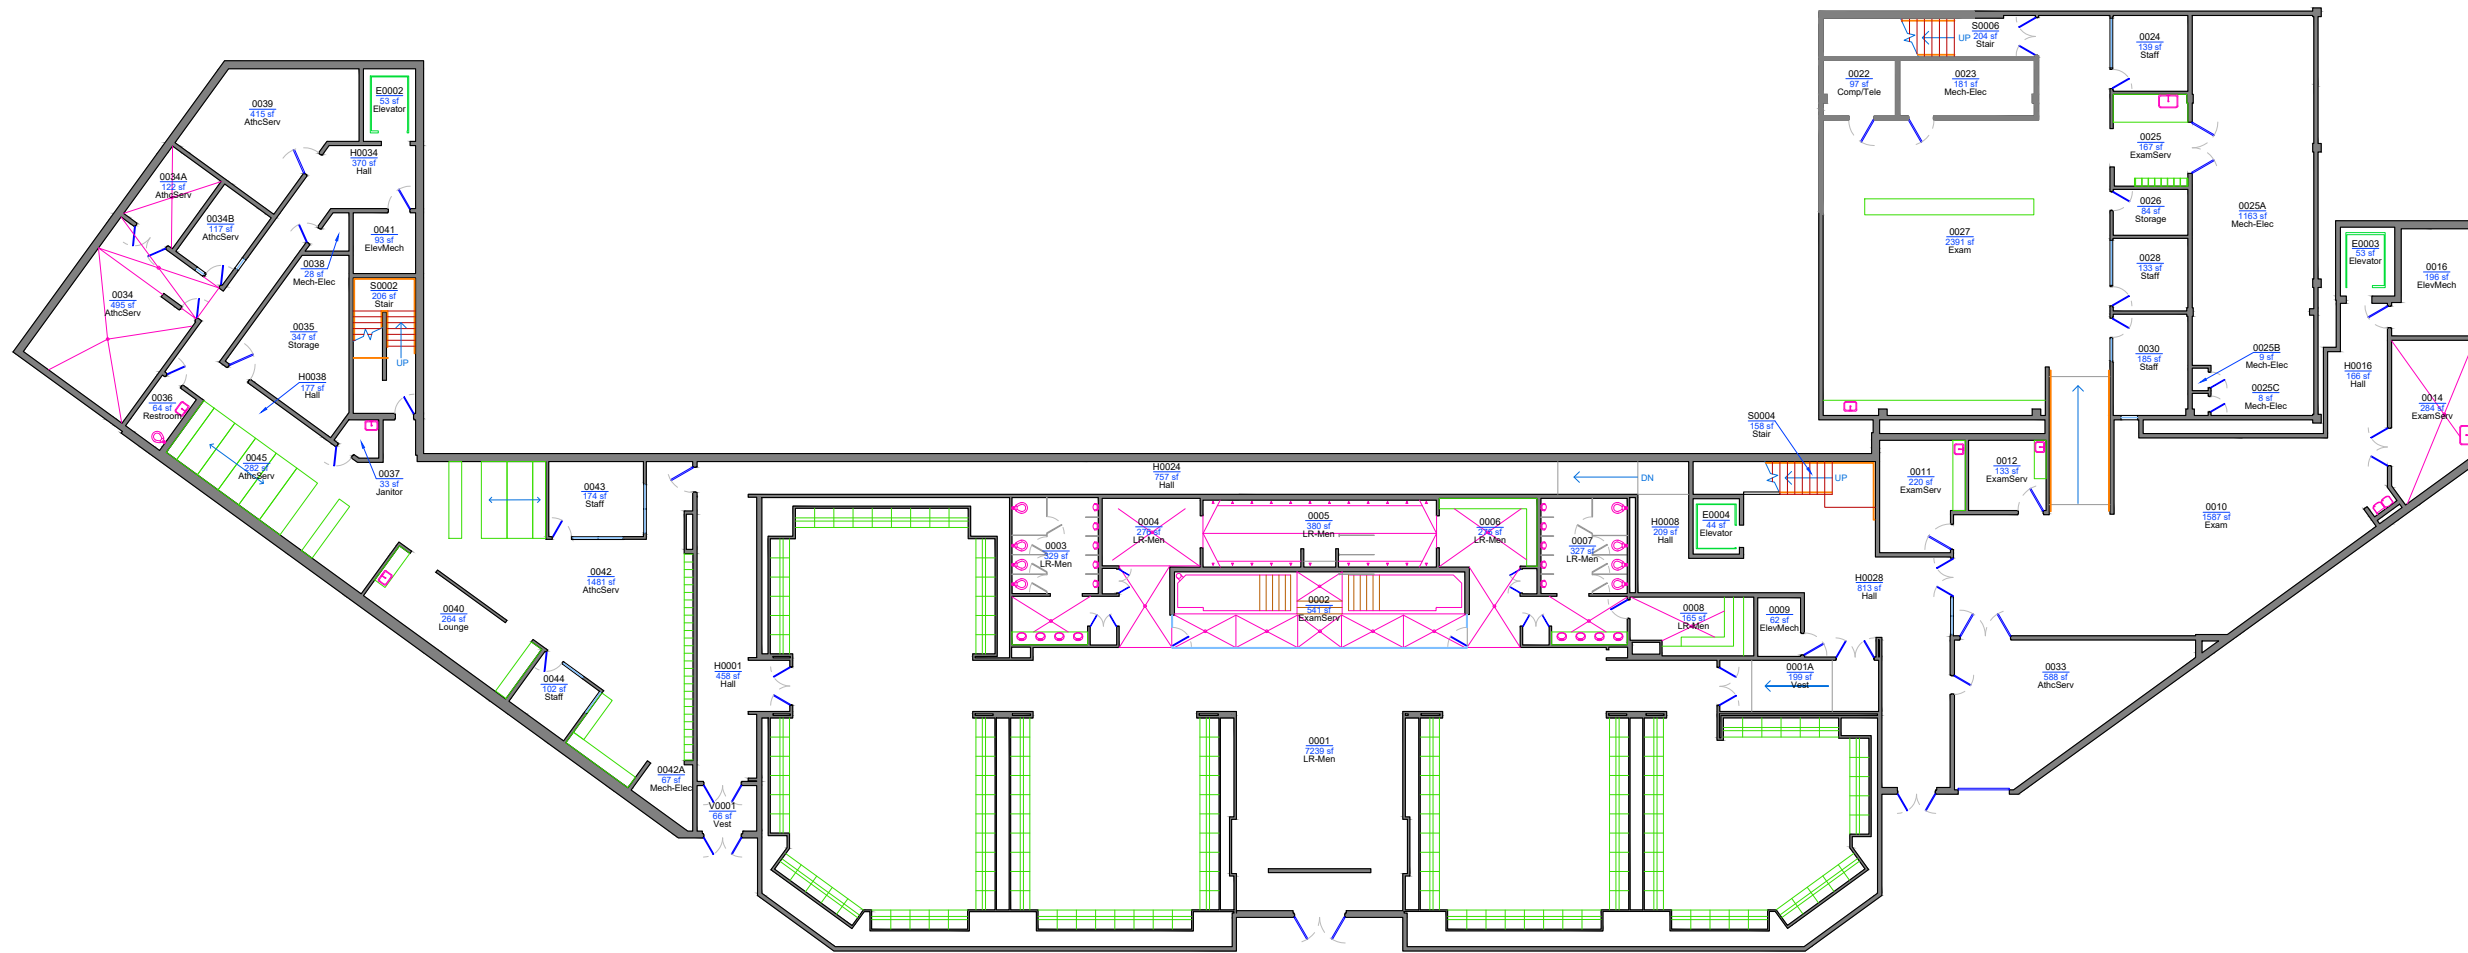

OSU FREE ACCESS INFORMATION

SHEET # **1**
 OF **4**

DATE	REVISED	DESCRIPTION
	A	

SCALE:
1" = 30'-0"

BASEMENT FLOOR

VALLEY FOOTBALL CENTER
0143 [VFBC]
725 SW 30TH ST.



Drawing Name
0143_0

FACILITIES RECORD DRAWING
 Scaled: 12/15/2017
 Date: 12/15/2017
 Project: August 19, 2019
 Orientation: Landscape
 Plot scale: 0.388866
 Paper size: 11x17
 Date: Nov
 Plot: up

Drawing Name
0143_2



Oregon State University

VALLEY FOOTBALL CENTER

**0143 [VFBC]
725 SW 30TH ST.**


SECOND FLOOR

SCALE:
1" = 30'-0"



CAUTION
THIS DRAWING IS
GENERAL IN NATURE AND
IS FOR REFERENCE ONLY

Field Verification NOTE:
Preference in accuracy was given to the interior room areas and shapes, not the thickness of walls or structural features. This may have an effect on OSU planners, PMAs, CMs, outside contractors, or others who might use the drawing as a guide for projecting required material, open penetration areas, or other regular information taken from CAD drawings. This is a Legacy issue that is nearly impossible to fix at this point of the buildings life especially as it is occupied.

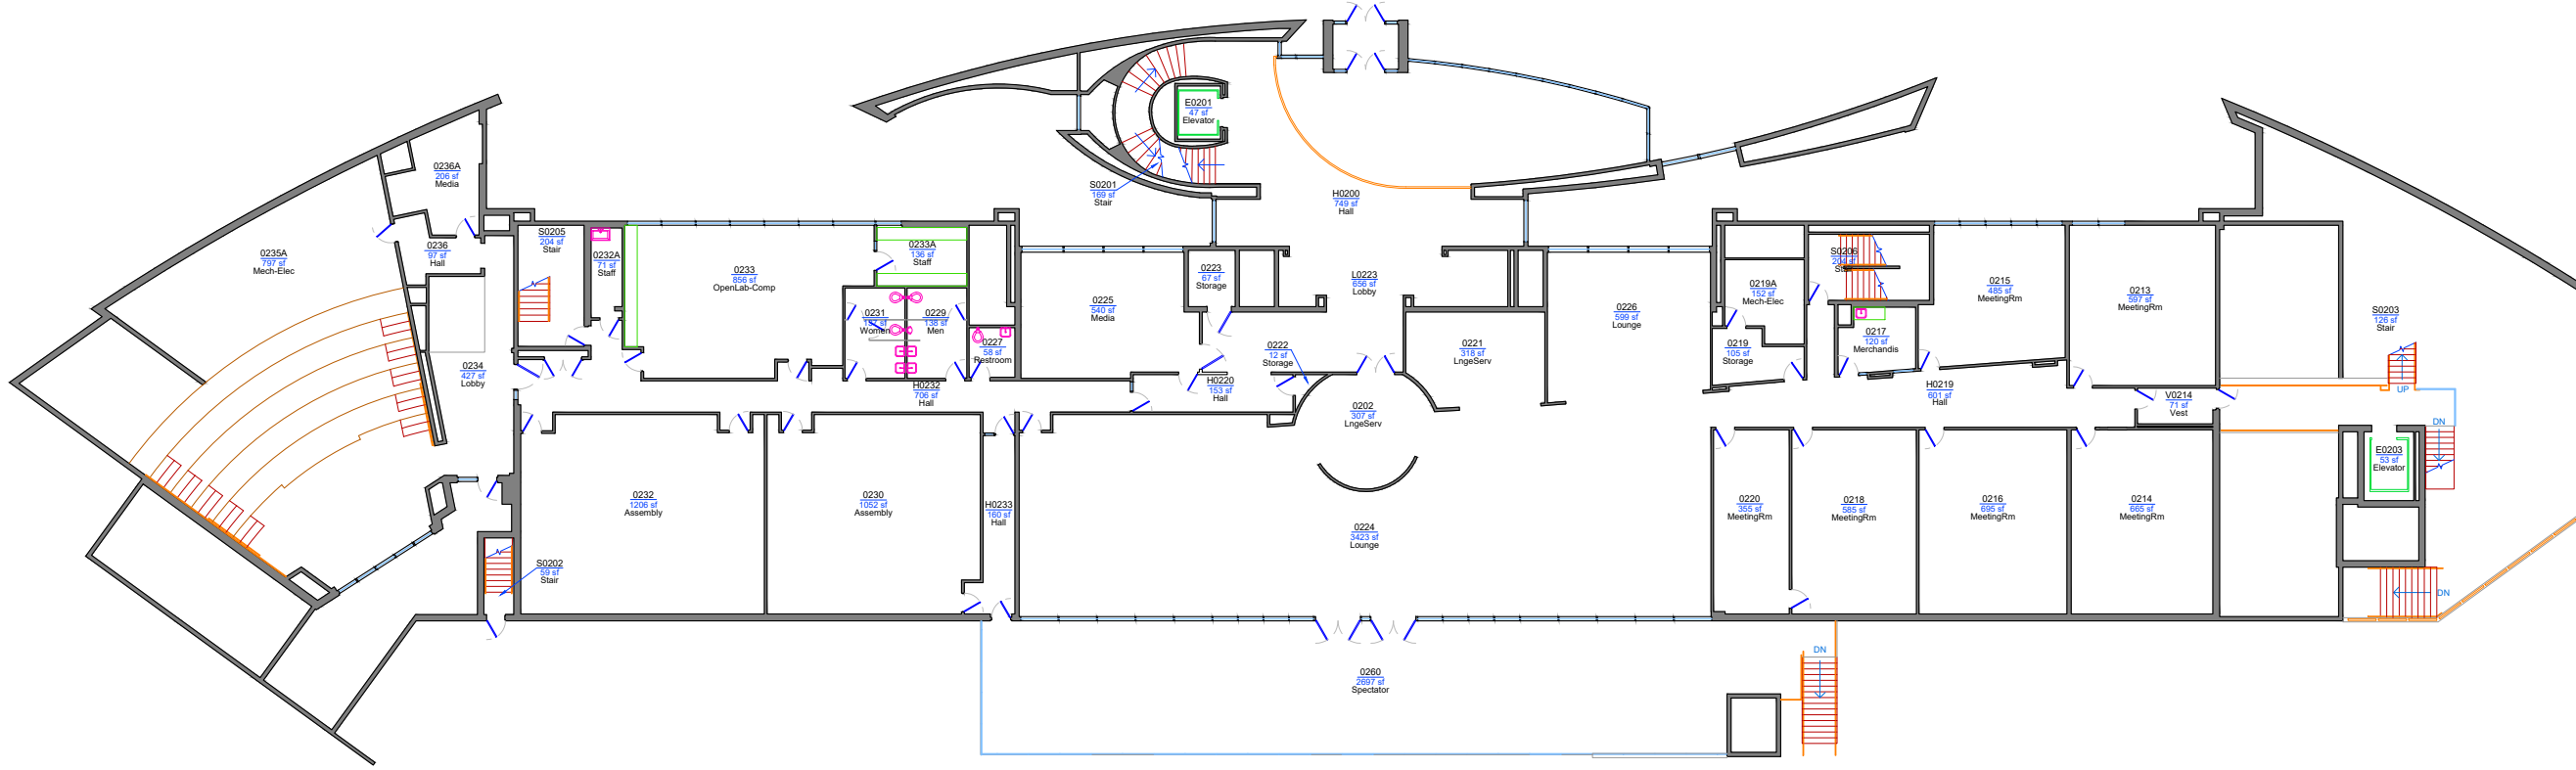


OSU FREE ACCESS INFORMATION

DATE	DRAWN	QC

FACILITIES RECORD DRAWING
 Drawn by: meakab
 Date: 06/06/2017
 Created: December 6, 2017
 Plotted: August 19, 2019
 Orientation: Landscape
 Plot scale: 0.388866
 Paper size: 11x17
 Dotted: None
 Plot on up: ...

SHEET # **3**
OF **4**

File path: S:\ACAD\CAD\Bookplan\Valley_Football_Center(VFBC)-0143\0143_2.dwg

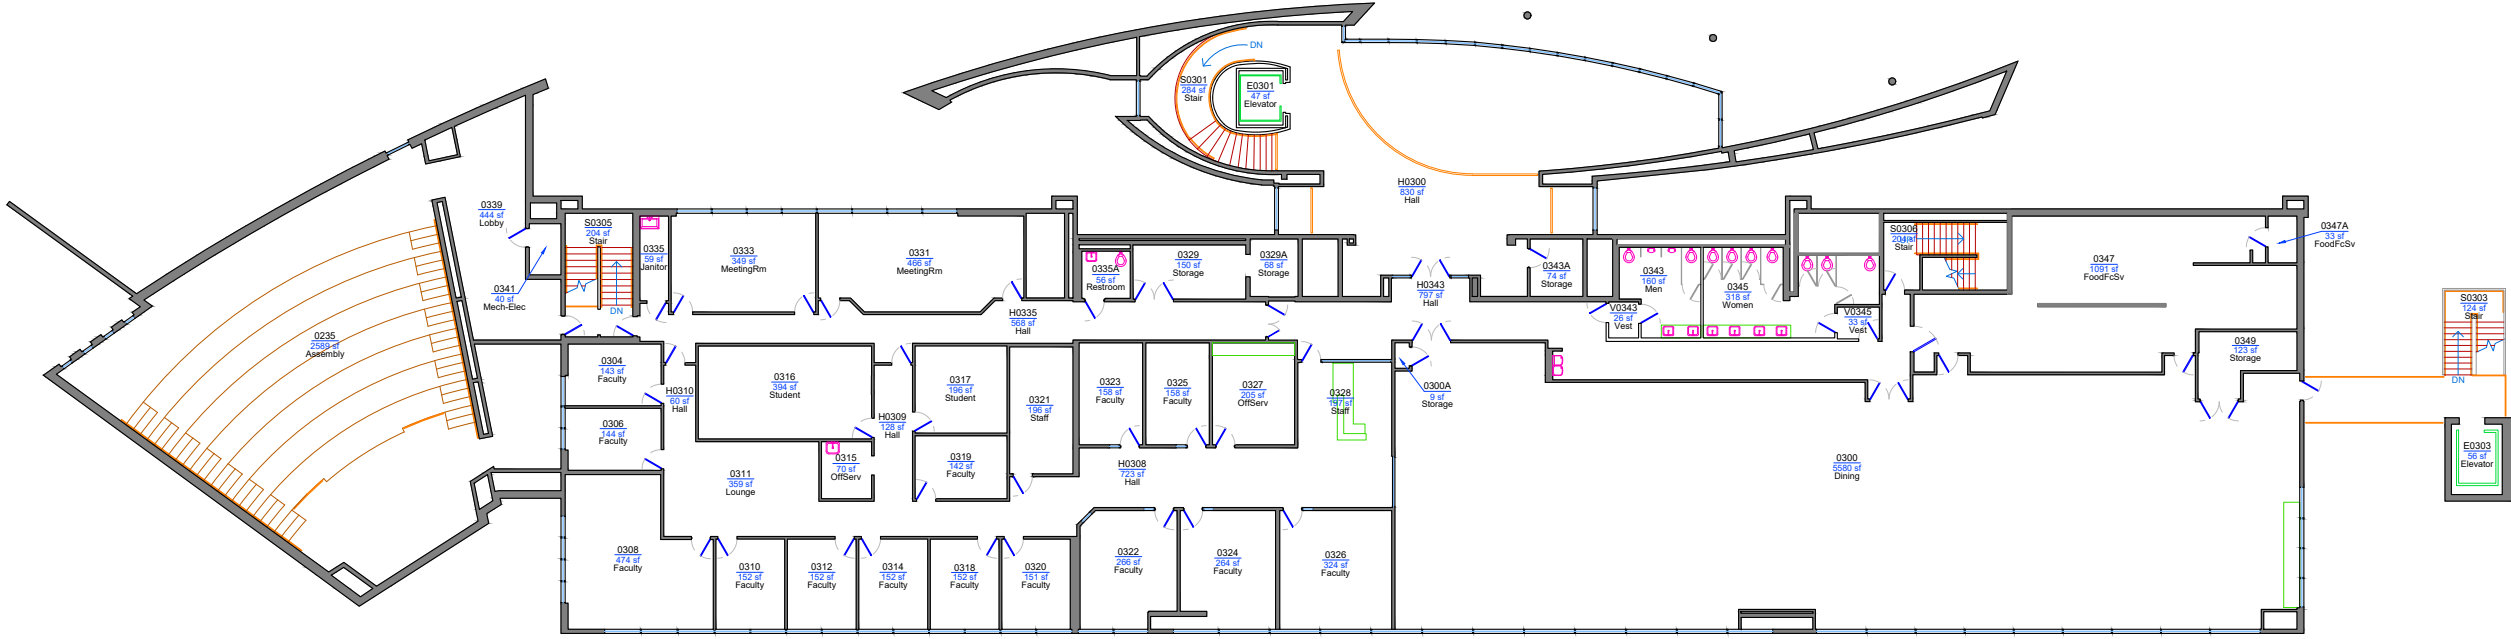

Drawing Name
0143_3



**Oregon State
University**

VALLEY FOOTBALL CENTER

0143 [VFBC]
725 SW 30TH ST.

**THIRD
FLOOR**

SCALE:
1" = 30'-0"

OSU FREE ACCESS INFORMATION

FACILITIES RECORD DRAWING
 Stanley: Bookplate - 30, 2017
 Date: 08/02/2017
 Created: November 30, 2017
 File Date: August 19, 2019
 Operator: Landscape
 Plot Scale: 0.386863
 Paper Size: 11x17
 Dotted: None
 Plot on up: -x-

DATE	Drawn	QC

SHEET # 4
OF 4

File path: S:\ACAD\CAD\Bookplan\Valley_Football_Center(VFBC)-0143\0143_3.dwg