

OSU College of
Agricultural
Sciences
Oregon State
UNIVERSITY

ARCHITECT:
Lowell A. Fausett
College of Ag Sciences
138 Strand Ag Hall
Corvallis, OR 97331
PHONE:
(541) 737-5903
FAX:
(541) 737-3178
EMAIL:
lowell.fausett@oregonstate.edu

As-Built Floor Plan
Simhuber Aquatics Research Laboratory
28645 East Highway 34
Corvallis, OR 97333

Drawn By:
L.A.F.

County
Lin

R/T & Section
R5W/T15S - Section 36

Tax Lot
500


Revision	
Date:	Number:
-	-
-	-
Building Number
TL-491B

Date
November 16, 2016

DRAWING SHEET

A1.1

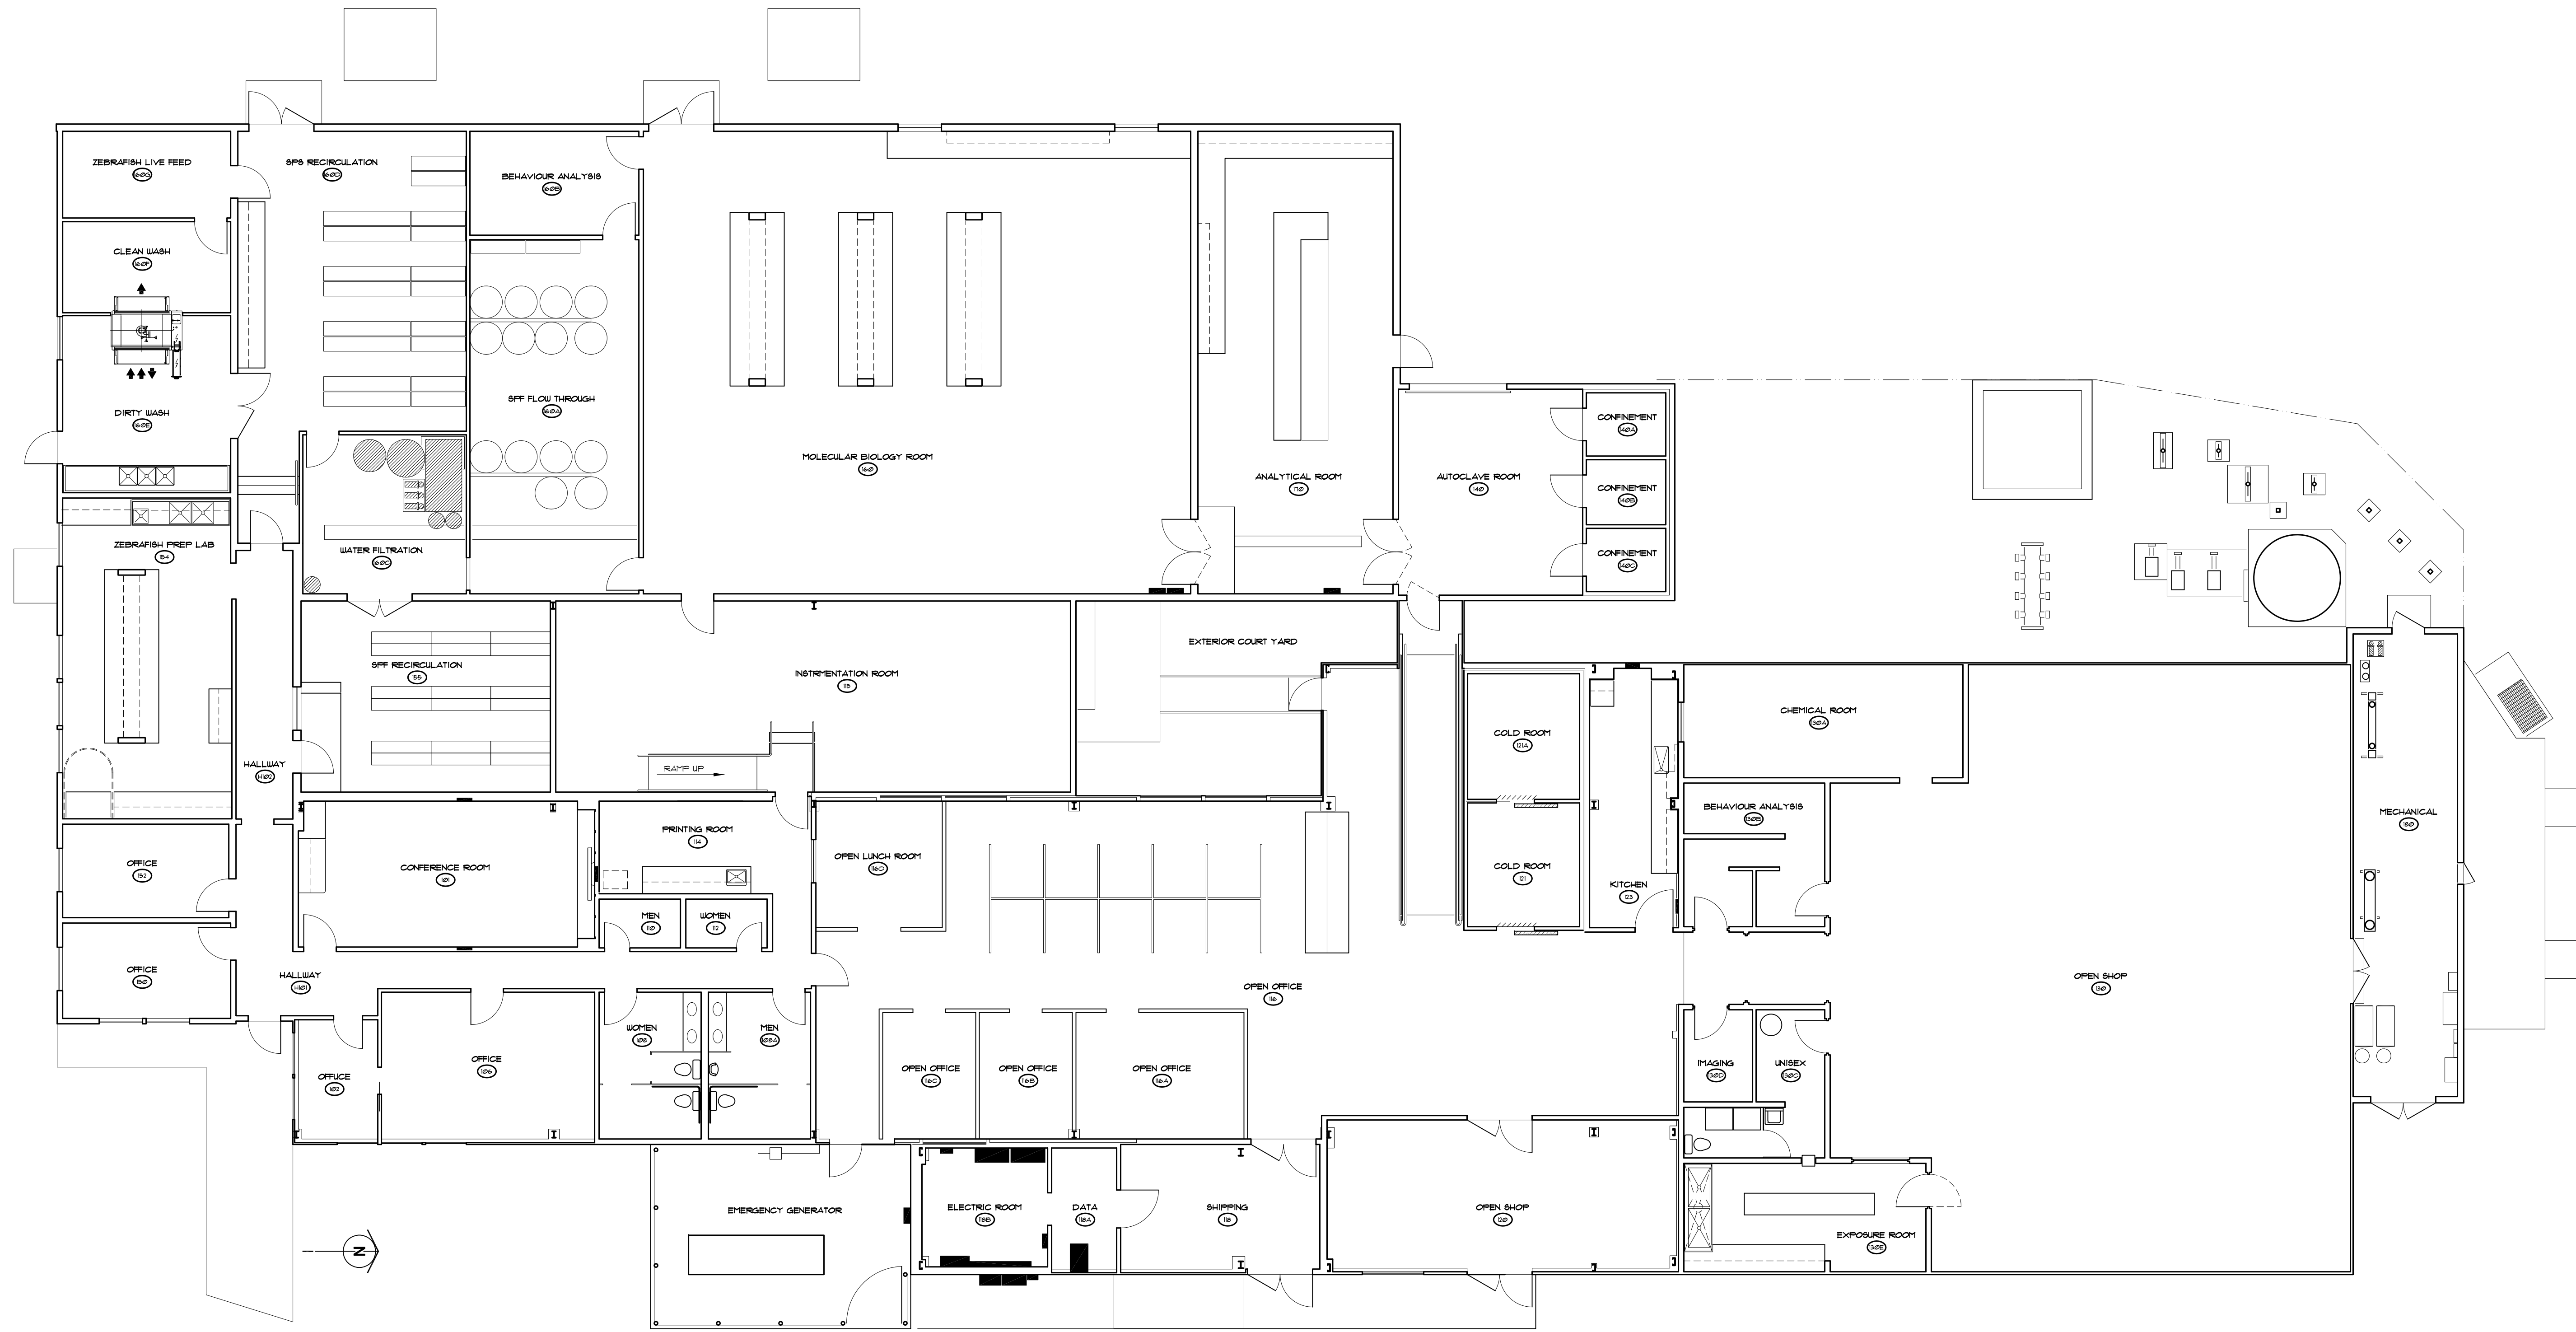

As-Built Floor Plan
SCALE: 1/8" = 1'-0"