BORING LOG

FROM OREGON HWY. BLD. LAB. PITTSBURG TESTING LABORATORY DATED 6-1-67

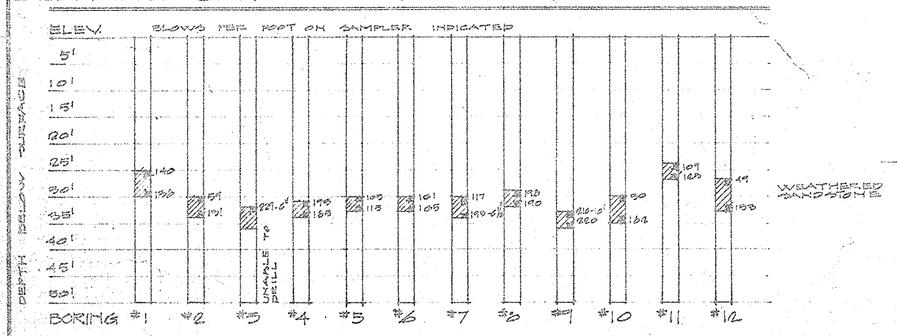

INDEX

ARCHITECTURAL :

R-7: SITE PLAN REV. >

1. SITE PLAN & INDEX
2. LOWER LEVEL PLAN & SITE DETAILS
3. GROUND FLR. & PLAZA LEVEL, UNIT C - DOOR DETAILS
4. GROUND FLR. & PLAZA LEVEL, UNIT D - & DETAILS
5. THIRD, FOURTH & FIFTH FLOOR PLANS, UNITS 'C' & D
6. FINISH SCHEDULE
7. STAIR & MISCEL. DETAILS
8. SECTIONS & ELEVATIONS
9. SECTIONS & ELEVATIONS
10. CONSTRUCTION DETAILS
11. WINDOW SCHEDULE & DETAILS
12. CORE AREA ELEVATIONS & DETAILS
13. MILLWORK
14. REFLECTED CEILING PLAN & DETAILS

BUILT-IN FURNITURE: F-1 STUDY ROOM FIXTURES

LANDSCAPING :

- L-1 SITE PLANTING PLAN
- L-2 PLAZA PLANTING PLAN
- L-3 SITE IRRIGATION PLAN
- L-4 PLAZA IRRIGATION PLAN

STRUCTURAL :

- S-1 FOUNDATION PLANS UNITS C & D
- S-2 COLUMN SCHEDULE & GENERAL NOTES
- S-3 SECOND FLOOR FRAMING PLANS
- S-4 THIRD FLOOR FRAMING PLANS
- S-5 FOURTH FLOOR FRAMING PLANS
- S-6 FIFTH FLOOR FRAMING PLANS
- S-7 ROOF FRAMING PLANS
- S-8 STAIR SECTIONS

MECHANICAL :

- M-1 SITE PLAN & SYMBOLS
- M-2 SCHEDULES
- M-3 EQUIPMENT & PIPING DIAGRAMS & DETAILS
- M-4 FLOOR PLANS, UNIT C (H&V.)
- M-5 FOUND. & FLOOR PLANS UNITS C&D, (H.&V.)
- M-6 FIFTH FLOOR MECH. RM'S. UNITS C&D
- M-7 FIRST & SECOND FLOOR PLANS UNIT C (PLUMB.)
- M-8 FLOOR PLANS UNIT D, RISER UNIT C (PLUMB.)
- M-9 FLOOR PLANS & RISERS UNITS C&D (PLUMB.)

R-4 CONNECTOR PIPING REVISIONS

- M-10 CONNECTOR SCHEDULE & DETAILS
- M-11 HEATING REVISIONS - MARQUESS
- M-12 HEATING REVISIONS - MARQUESS

ELECTRICAL :

- E-1 SITE PLAN & SCHEDULE
- E-2 GROUND & SECOND FLOOR LIGHTING PLAN, UNIT C
- E-3 GROUND & SECOND FLOOR POWER PLAN, UNIT C
- E-4 GROUND & SECOND FLOOR POWER & LIGHTING UNIT D
- E-5 THIRD, FOURTH, & FIFTH FLOOR LIGHTING UNITS C & D.
- E-6 THIRD, FOURTH, & FIFTH FLOOR POWER UNITS C & D.

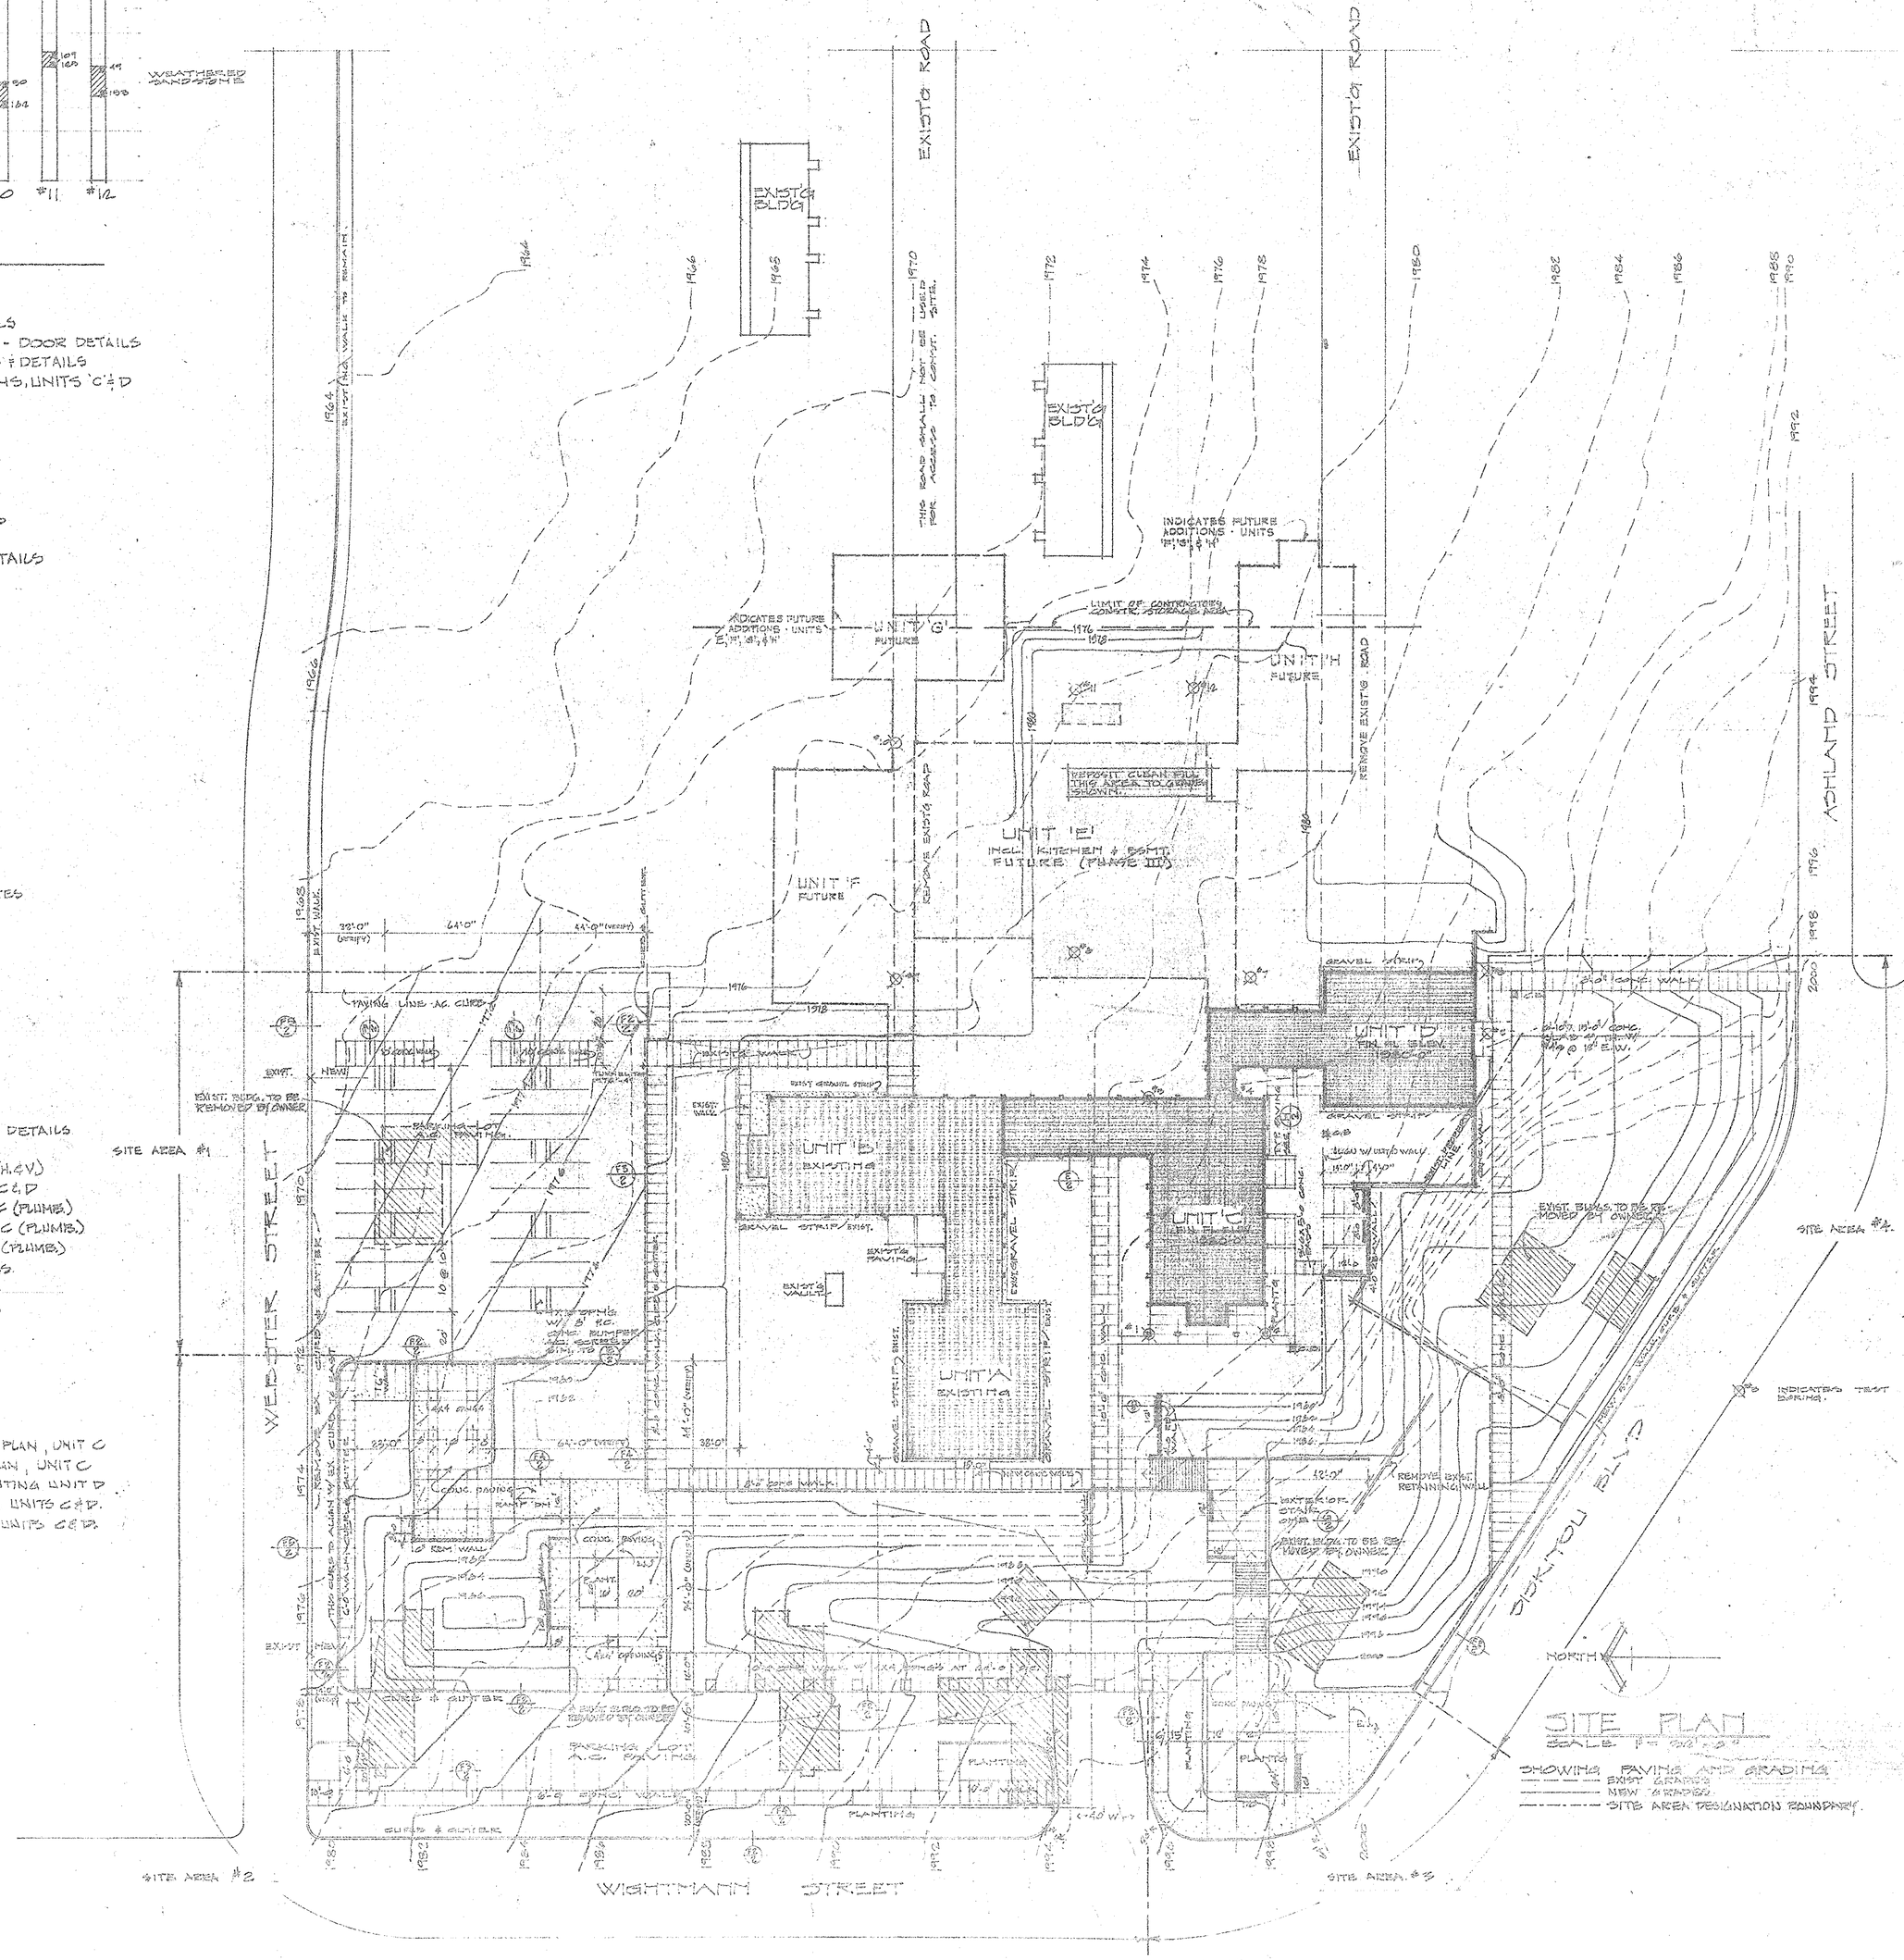

NOTE! SEE SHEET R-7 FOR EXTENSIVE SITE WORK REVISIONS.

AS BUILT DRAWINGS

REGISTERED ARCHITECT STATE OF OREGON

ARCHITECTS WILMSEN ENDICOTT UNTHANK & ASSOCIATES AIA
812 S.W. WASHINGTON
863 THIRTEENTH AVENUE EAST
PORTLAND, OREGON 97205
EUGENE, OREGON 97401
223-2697
344-3249

GREEN SPRINGS DORMITORY COMPLEX
SOUTHERN OREGON COLLEGE OF HIGHER EDUCATION
OREGON STATE SYSTEM OF HIGHER EDUCATION
ASHLAND, OREGON

STAGE II
UNITS C, D, E

APPROVED
DRAWN
DATE 3 OCT. '67
JOB 643-67
REVISED OCT. 3, 1967.

NO REQUIRED REVISIONS PER R.T. 2/21/68 DATE

SITE PLAN AND INDEX

1

FINAL SITE PLAN