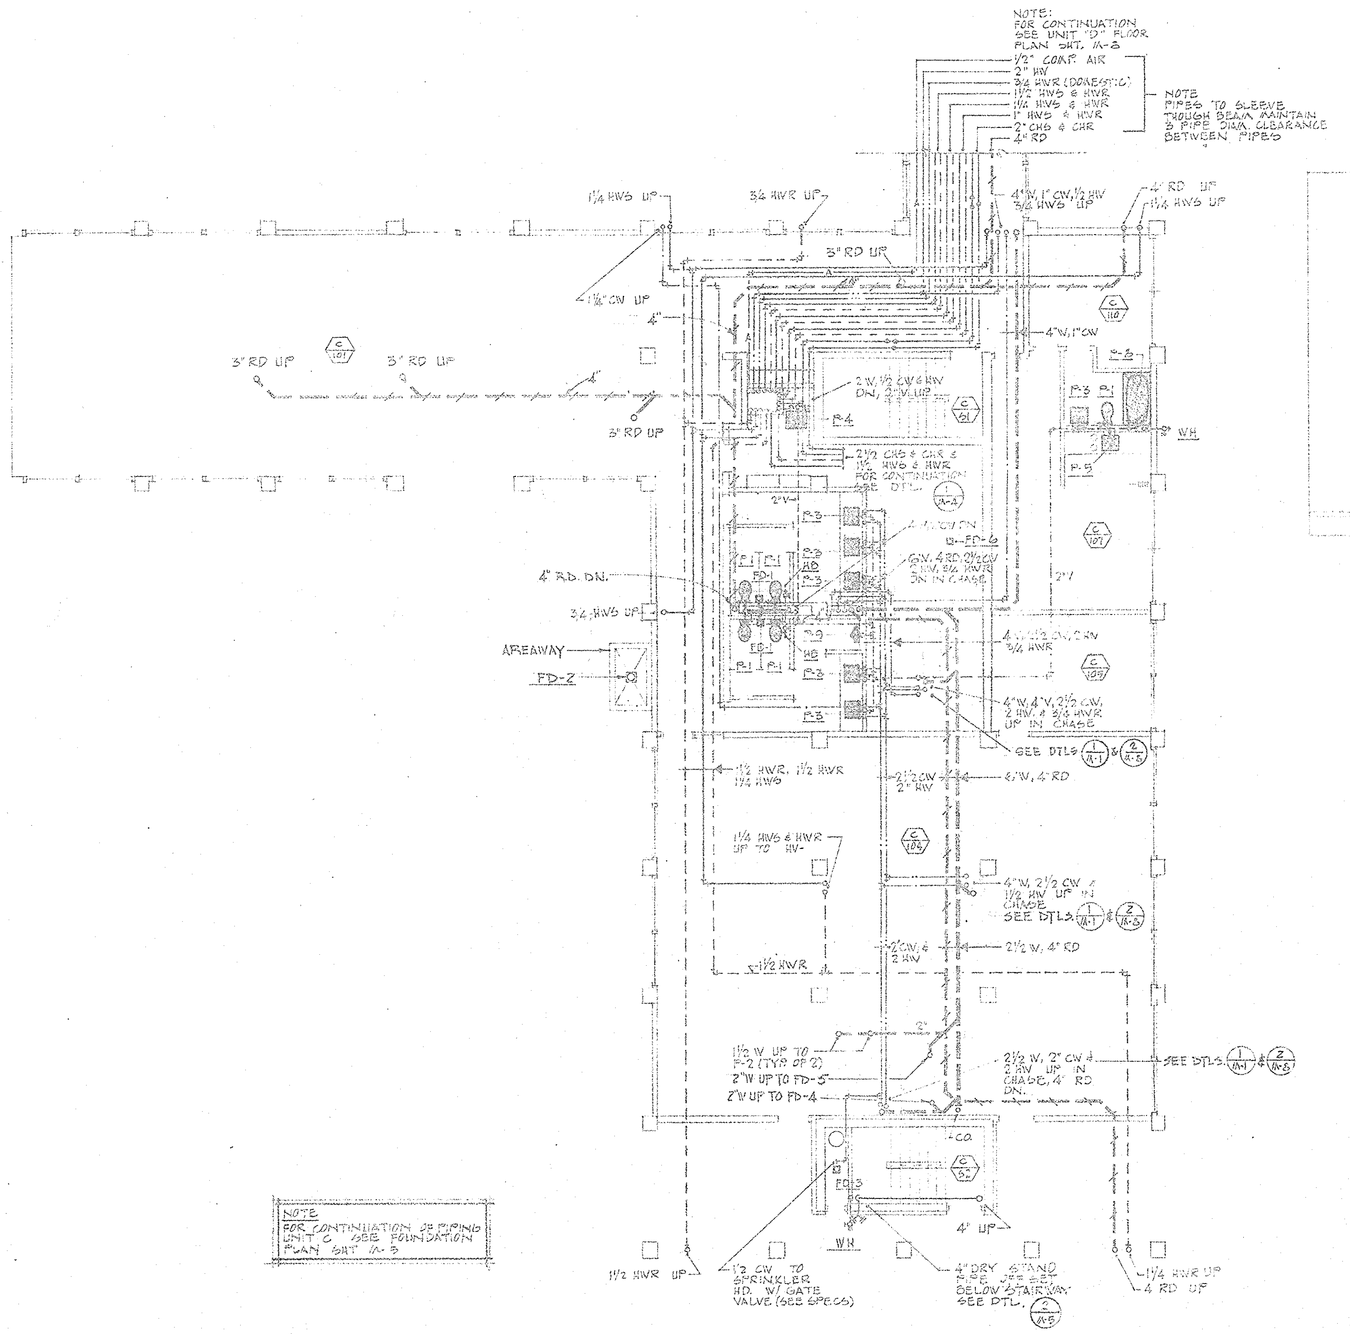

UNIT "C" ~ GROUND FLOOR PLAN SCALE 1/8"=1'-0"

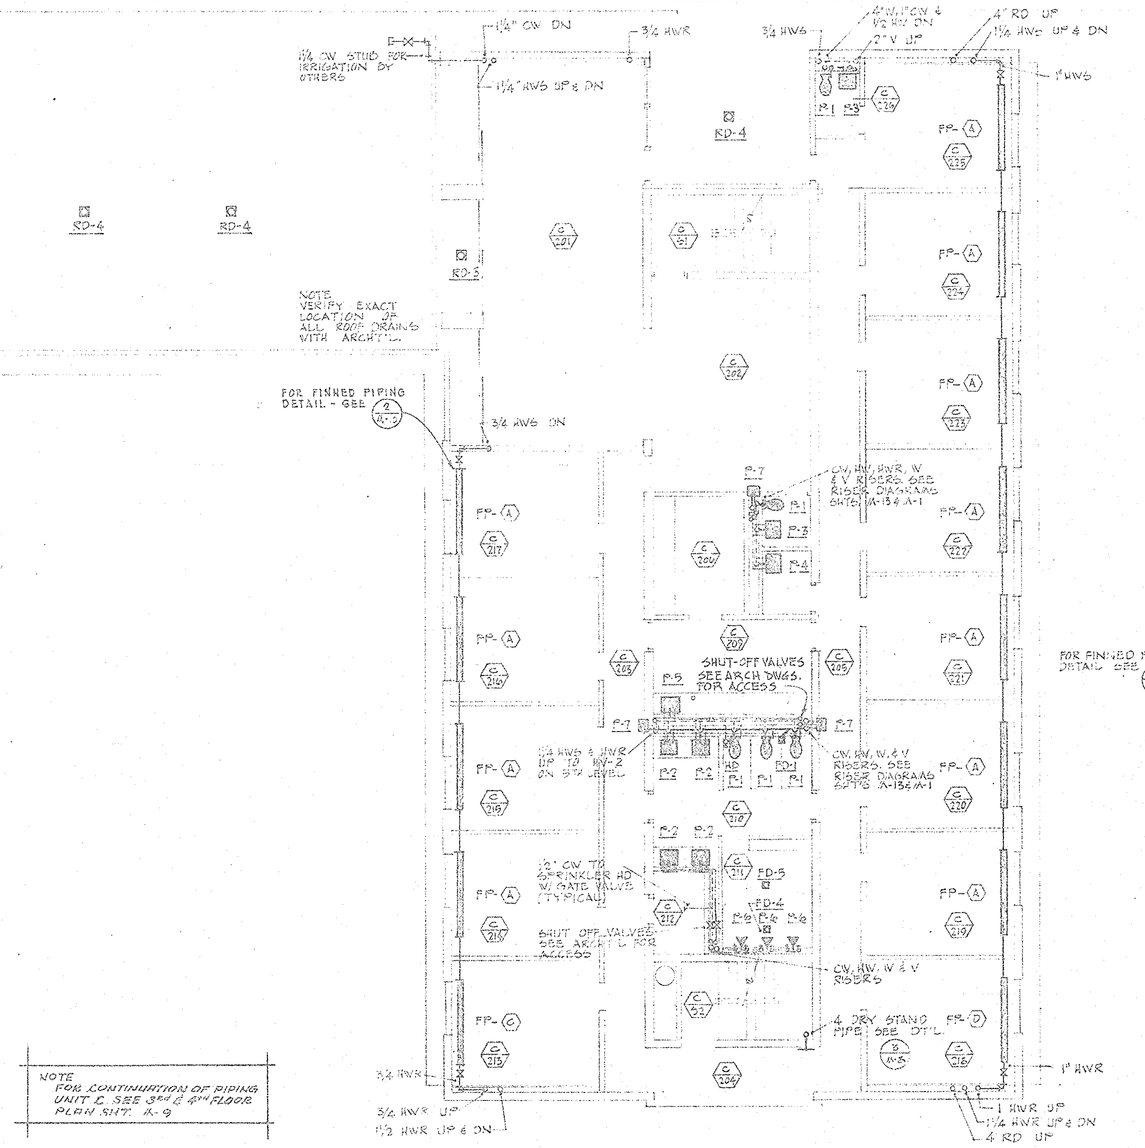

UNIT "C" ~ SECOND FLOOR PLAN SCALE: 1/8"=1'-0"

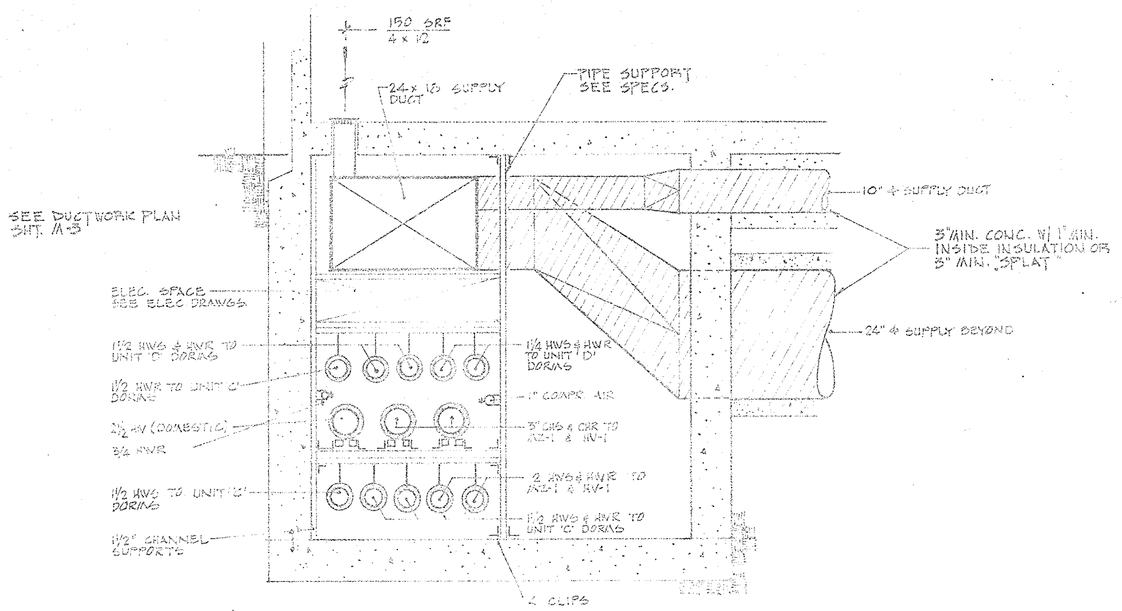

1/A-7 UTILITY TUNNEL SECTION SCALE 3/4"=1'-0"

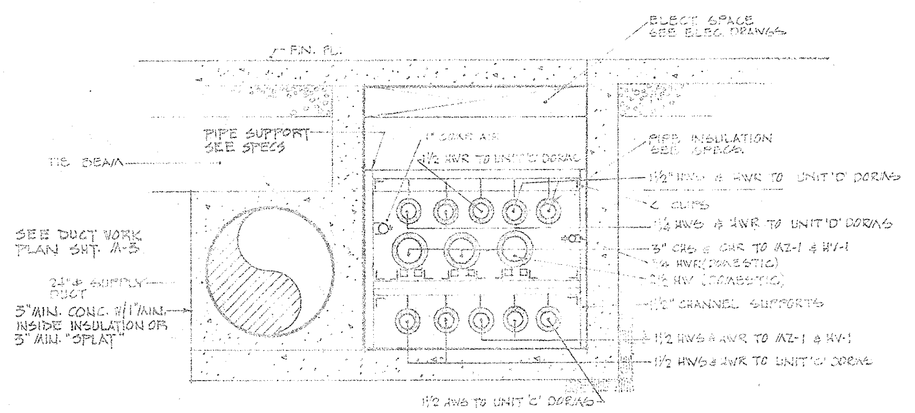

2/A-7 PIPE TRENCH SECTION SCALE: 3/4"=1'-0"

ARCHITECTS
WILMSEN ENDICOTT UNTHANK & ASSOCIATES AIA
PORTLAND, OREGON 97205 223-2607
EUGENE, OREGON 97401 344-3249
812 S. W. WASHINGTON
863 THIRTEENTH AVENUE EAST

STAGE II
UNITS C, D,

FOR DORMITORIES - DORMITORY COMPLEX
SOUTHERN OREGON COLLEGE
OREGON STATE SYSTEM OF HIGHER EDUCATION
ASHLAND, OREGON

APPROVED
DRAWN
DATE 5 OCT. 67
JOB 483-67

AS BUILT 2/21/67
REVISIONS DATE

1ST & 2ND PLUMBING PLANS UNIT 'C'

M7