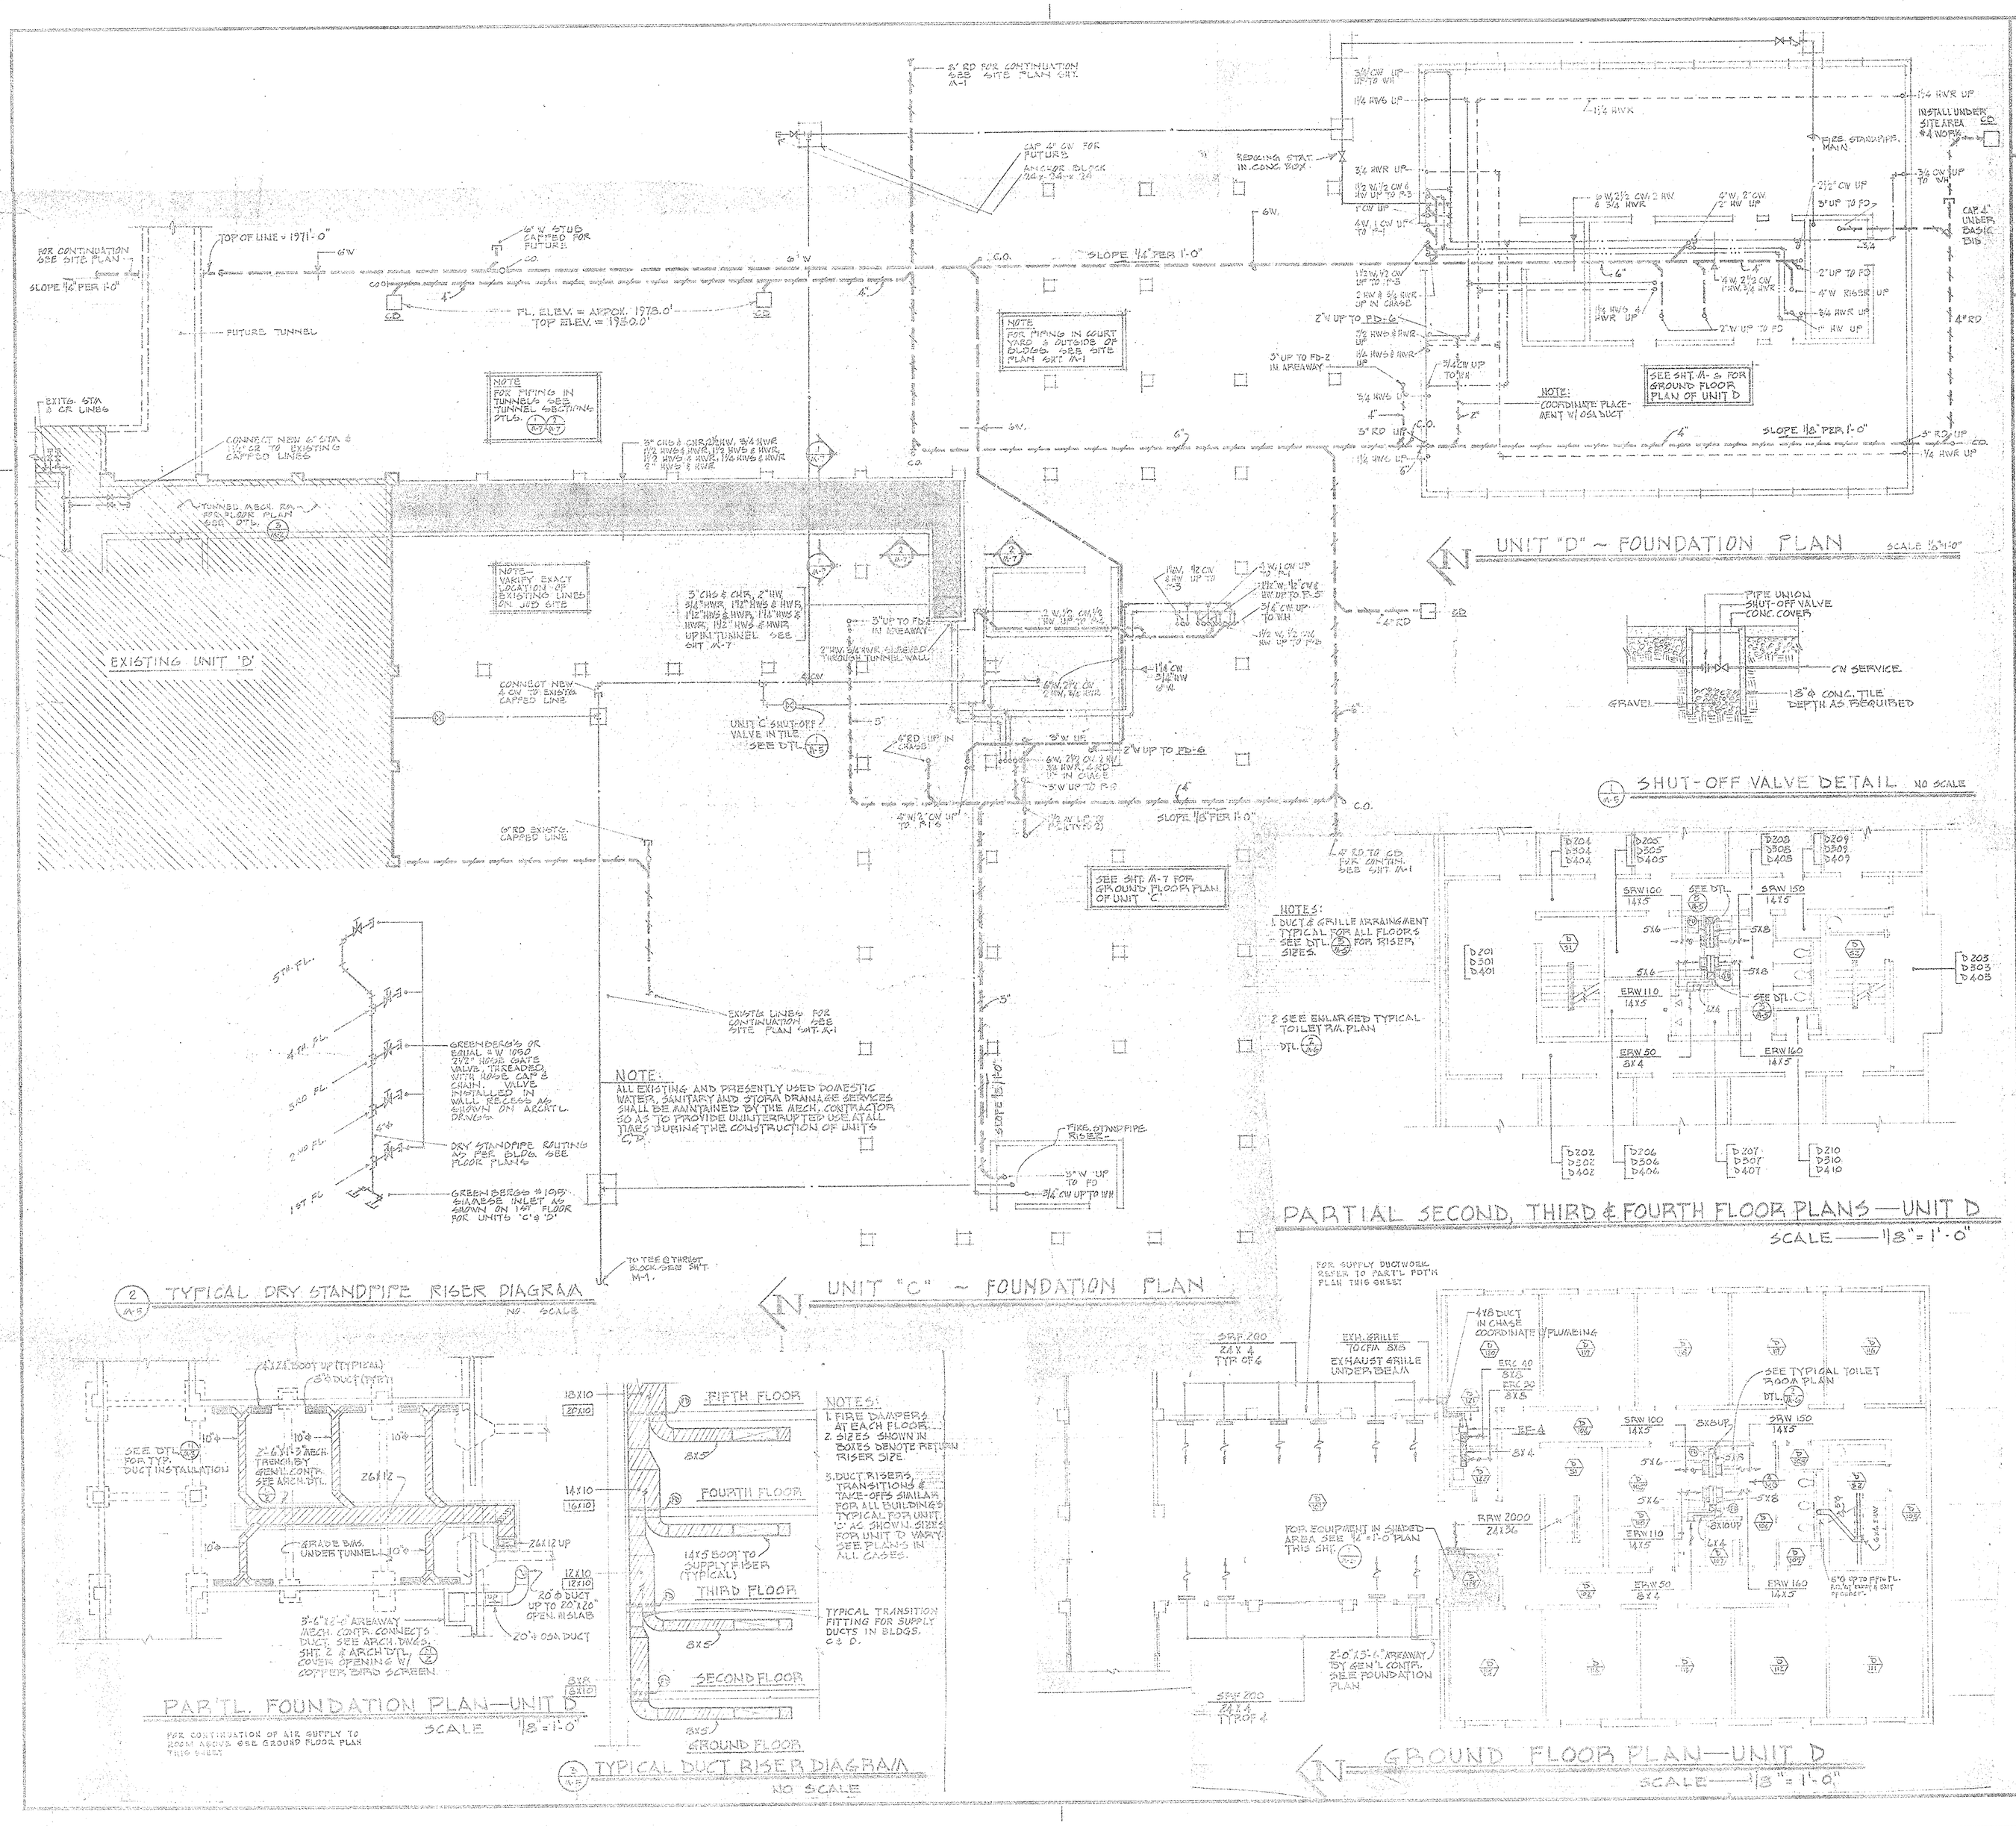

ARCHITECTS
WILMSEN ENDICOTT UNTHANK & ASSOCIATES AIA
PORTLAND, OREGON 97205 223-2607
EUGENE, OREGON 97401 344-3249
863 THIRTEENTH AVENUE EAST

REGISTERED ARCHITECT — STATE OF OREGON

STAGE II
UNITS C, D

APPROVED
DRAWN
DATE 3 OCT. 67
JOB 453-67

As Built 8/31/68
REVISIONS DATE

C & D FLOOR & FOUNDATION PLANS - RISER DIAGRAMS

M5

67-A-270